


G-8118  
66811

# T. 38 & 39S., R. 20E., WM.

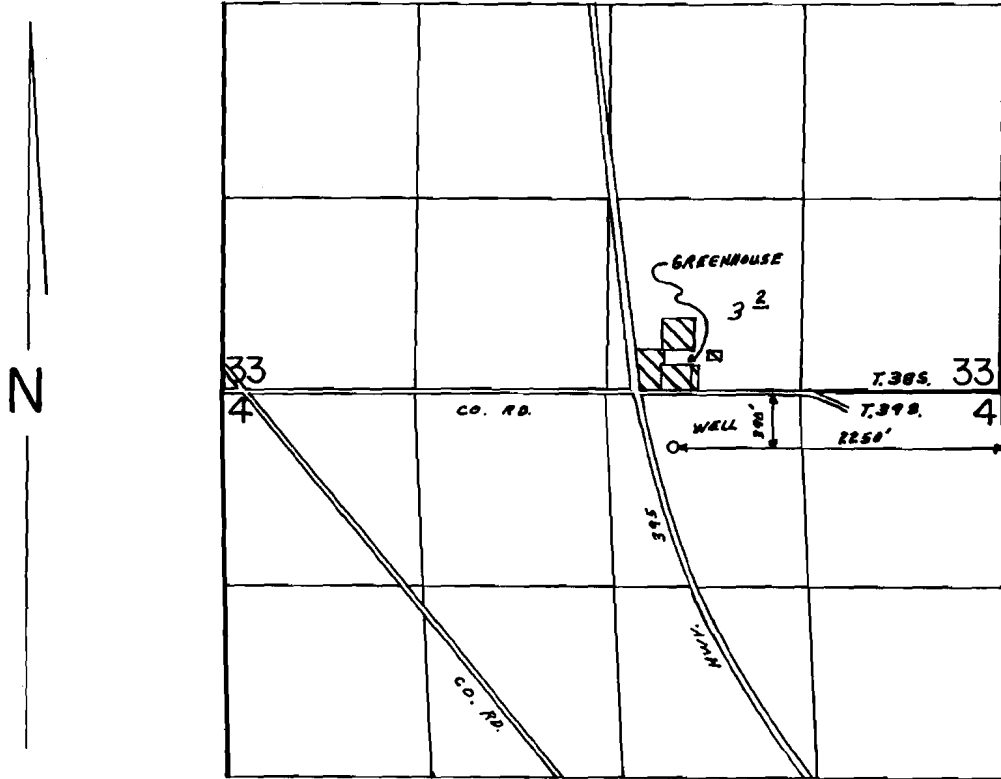

SCALE: 1"=1320'

## FINAL PROOF SURVEY UNDER

Application No. G-5217 Permit No. G-8118.....  
IN NAME OF Cert # 66811

.....ROBERT C. UTLEY.....

Surveyed OCT. 20, 1988, by B. BISHOP.....