


T. 10 S., R. 3 W., W.M.

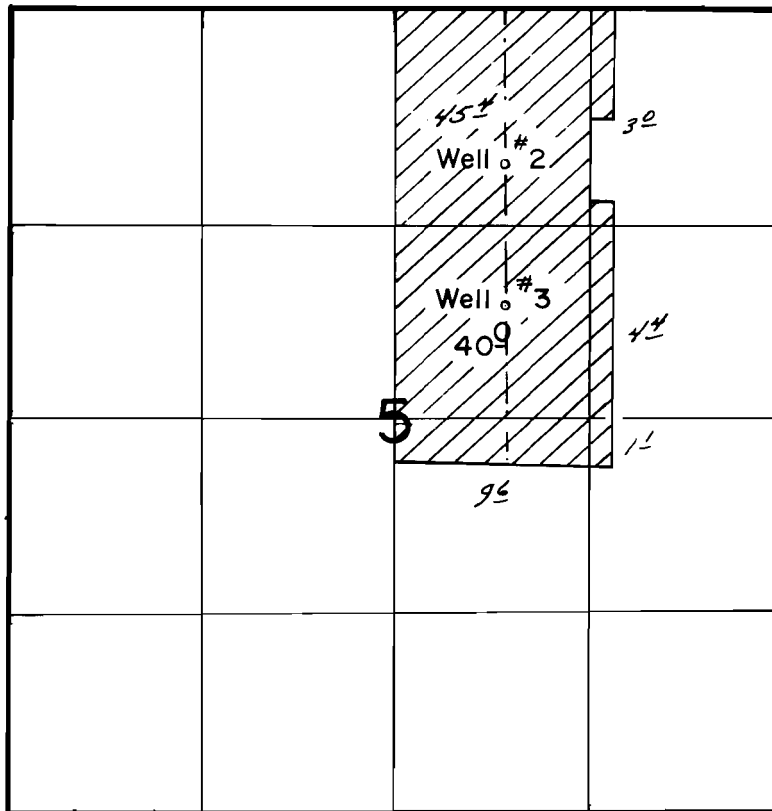

WELLS LOC. — #2 - 1880'S E 1900' N BOTH FROM NE COR. SEC. 5  
#3 - 2050'S E 1900' N

**FINAL PROOF SURVEY**  
UNDER

Application No. G-7686 Permit No. G-7112  
IN NAME OF

DAVID C. HARNISCH

Surveyed Sept. 5, 1978, by J.S. DONALDSON  
Re-tie - APRIL 23, 1979, by S.C. BROWN