


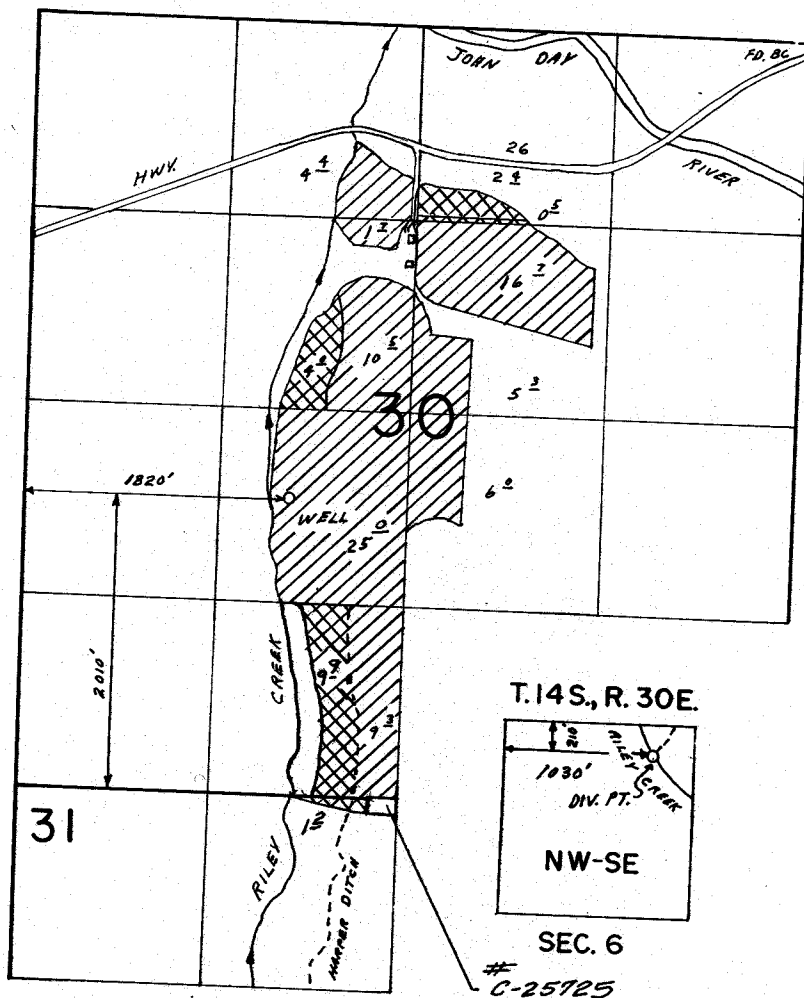

T.13S., R. 30E., W.M

P-45710  
L2816  
L2815



SCALE: 1"=1320'

-  PERMIT 45710 PRIMARY
-  PERMIT G-9305 SUPPLEMENTAL

### FINAL PROOF SURVEY UNDER

Application No. 6 0073 Permit No. 45710  
G-9703 G-9305  
IN NAME OF

FRANCIS L. & MARY Y. MARCIEL

Surveyed MAR. 19 1986, by V.L CHURCH