


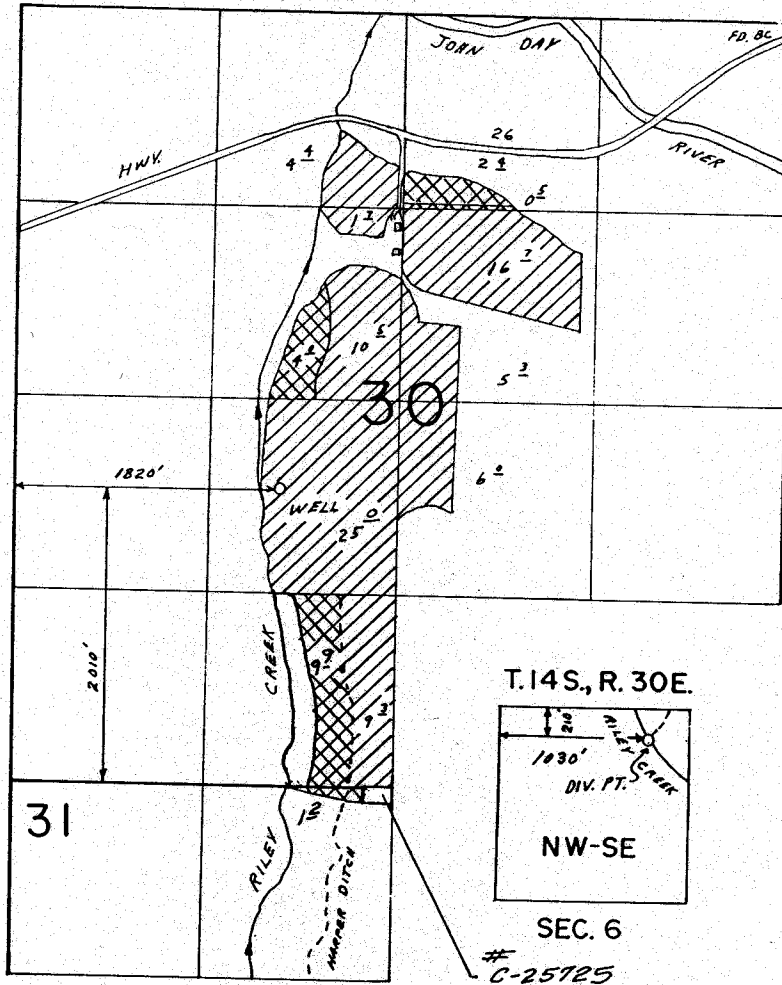

T.13S., R. 30E., W.M

P-45710
C-66816



SEC. 6
C-25125

SCALE: 1"=1320'

-  PERMIT 45710 PRIMARY
-  PERMIT G-9305 SUPPLEMENTAL

FINAL PROOF SURVEY UNDER

Application No. 6 0073 Permit No. 45710
G-9703 G-9305
 IN NAME OF
FRANCIS L. & MARY Y. MARCIEL
 Surveyed MAR. 19 1986, by V.L CHURCH