


T. 38 S., R. 5 W., W. M.

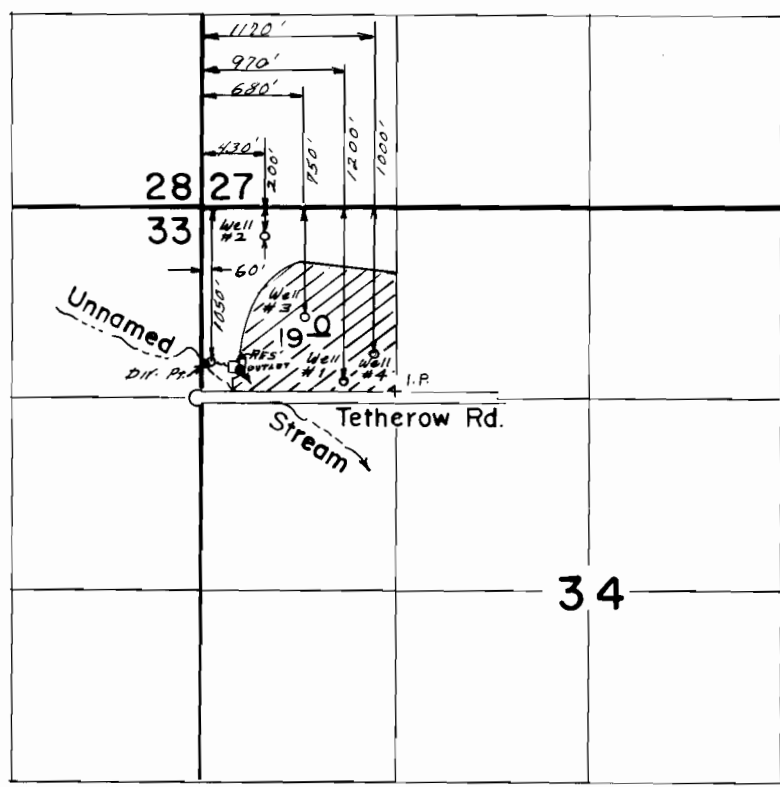

Scale: 1" = 1320'

FINAL PROOF SURVEY

UNDER

G-10341 G-9572

R-58188 R-7918

Application No. 58189 Permit No. 44364

IN NAME OF

RAYMOND & MARGARET PRAG

Surveyed AUG 8 1988, by B. S. JAMES