


T.16S.,R.24E.,W.M.

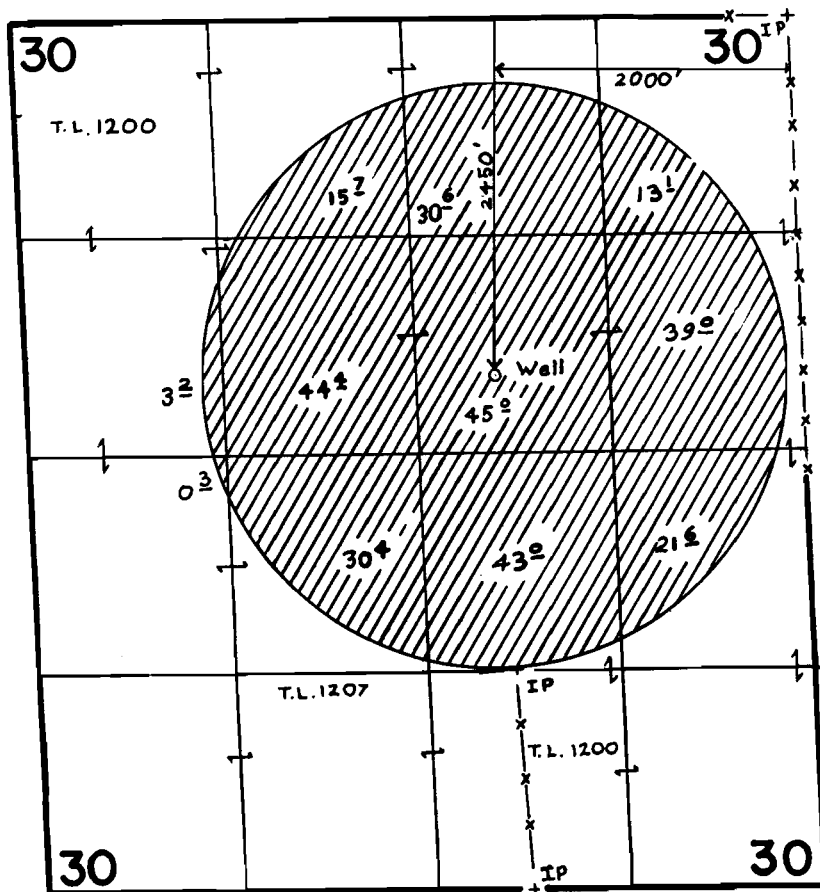

SCALE: 1"=1320'

FINAL PROOF SURVEY
UNDER

Application No. G-10676 Permit No. G-10049.....

C-66821

IN NAME OF

FAYNE F. AND JESSIE M. RITCH


Surveyed JULY 9..... 1986., by LESLIE OLSON.....

Rec'd 12-13-91
WD#11

1 of 2
G-10049

SECTIONAL LAYOUT OF SECTION 30 IS MORE APPROXIMATED BY RED LINES. THIS LAYOUT DERIVED FROM PAULINA 7 1/2' QUAD. 1981 EDITION

T.16S., R.24E., W.M.

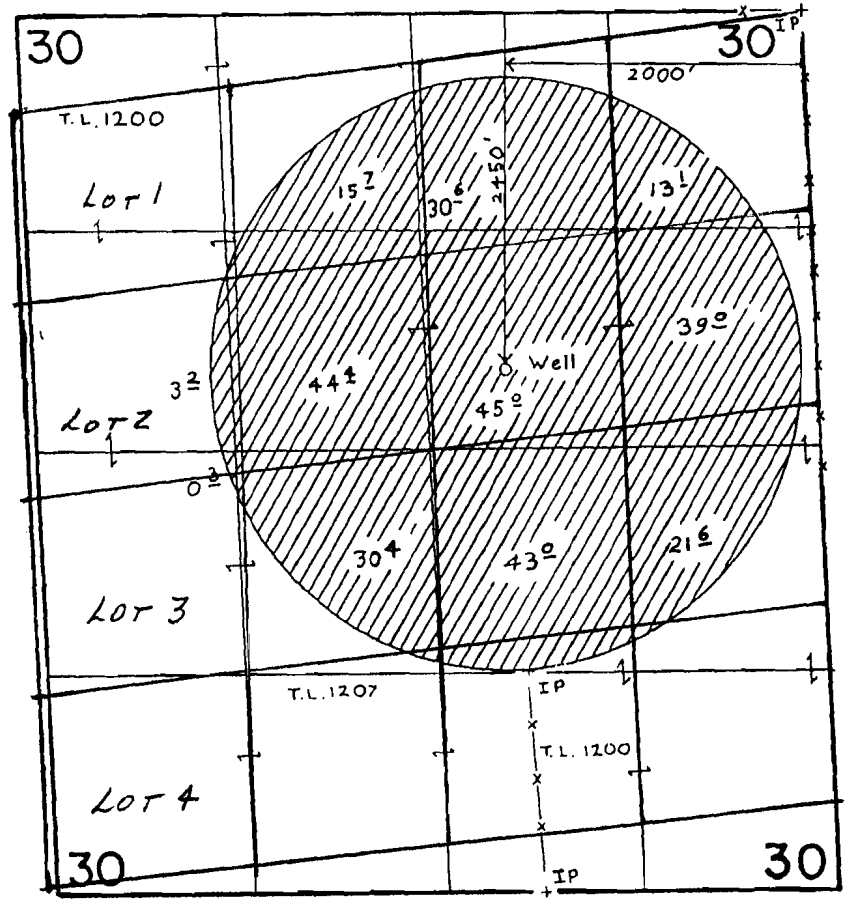

SCALE: 1"=1320'

FINAL PROOF SURVEY
UNDER

Application No. G-10676 Permit No. G-10049.....
IN NAME OF
FAYNE F AND JESSIE M. RITCH

Surveyed JULY 9..... 1986., by LESLIE OLSON.....

Rec'd 12-13-91
WD#11

#2 of 2
G-10049