


T. 6 N., R. 35 E., W.M.

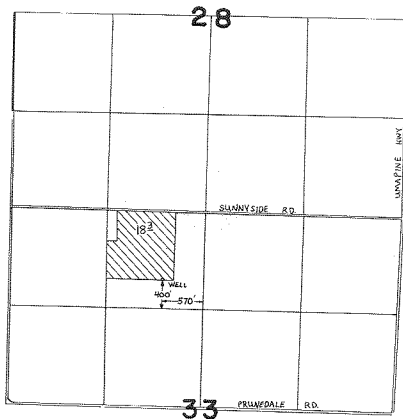

FINAL PROOF SURVEY
UNDER

Application No. G.10892. Permit No. G.10083.
IN NAME OF

RICHARD H. & BARBARA L. KNOPF

Surveyed May 9 1986, by J. Sauter