


21-10084
66823

T. 6 N. R. 35 E. W.M.

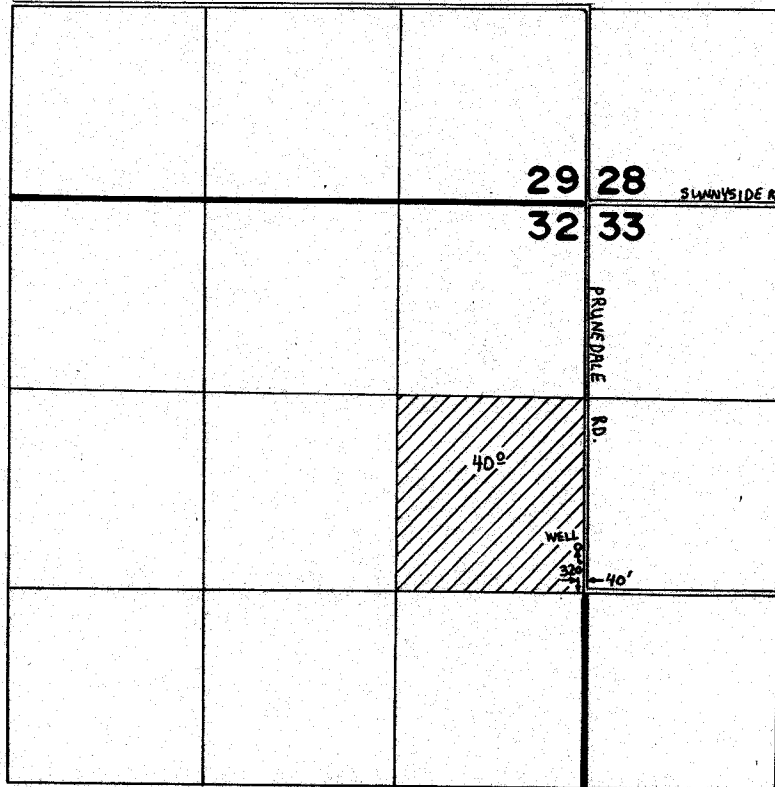

Scale 1"=1320'



FINAL PROOF SURVEY UNDER

Application No. G.10895. Permit No. G.10084...
IN NAME OF

RICHARD H. & BARBARA L. KNOPF

Surveyed May 9, 1986, by J. Sauter.....