


T. 37 & 38 S. R. 4 & 5 W., W. M.

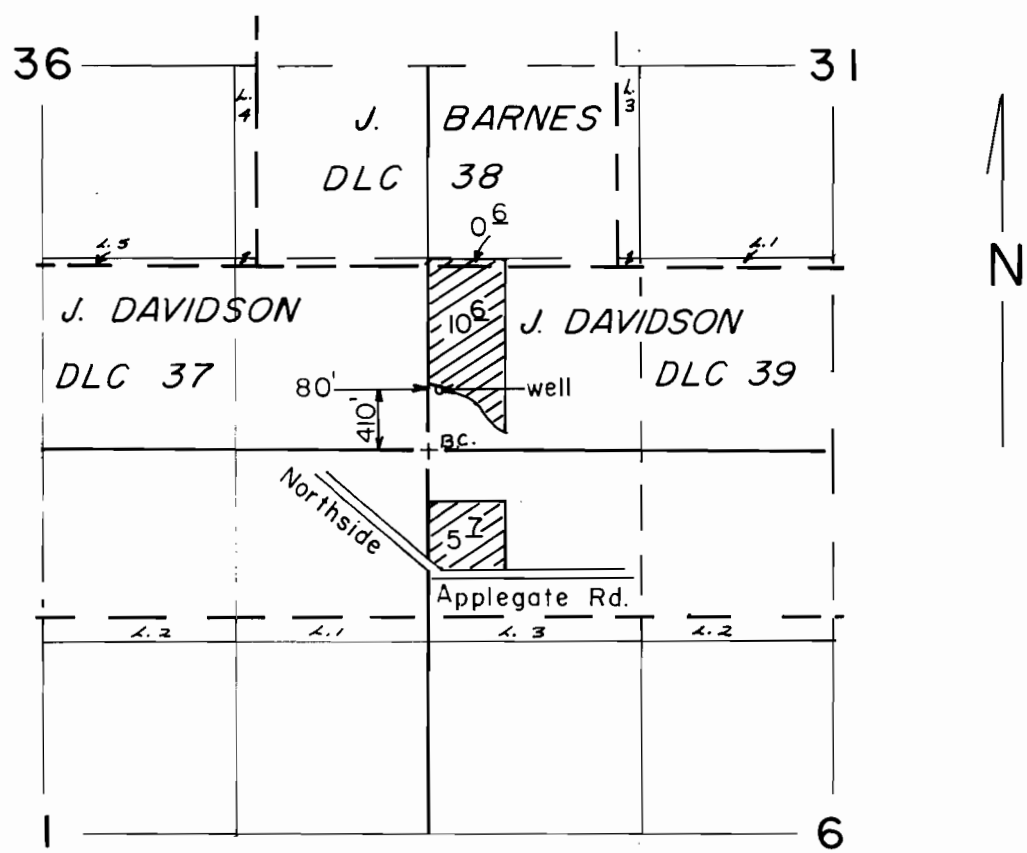

Scale: 1" = 1320'

FINAL PROOF SURVEY UNDER

Application No. G:111.35... Permit No. G:10.3.3.4.
IN NAME OF

ROBERT A. YOUNG

Surveyed NOV. 14. 19.89, by R. S. JAMES...