


T. 38 S., R. 8 W., W. M.

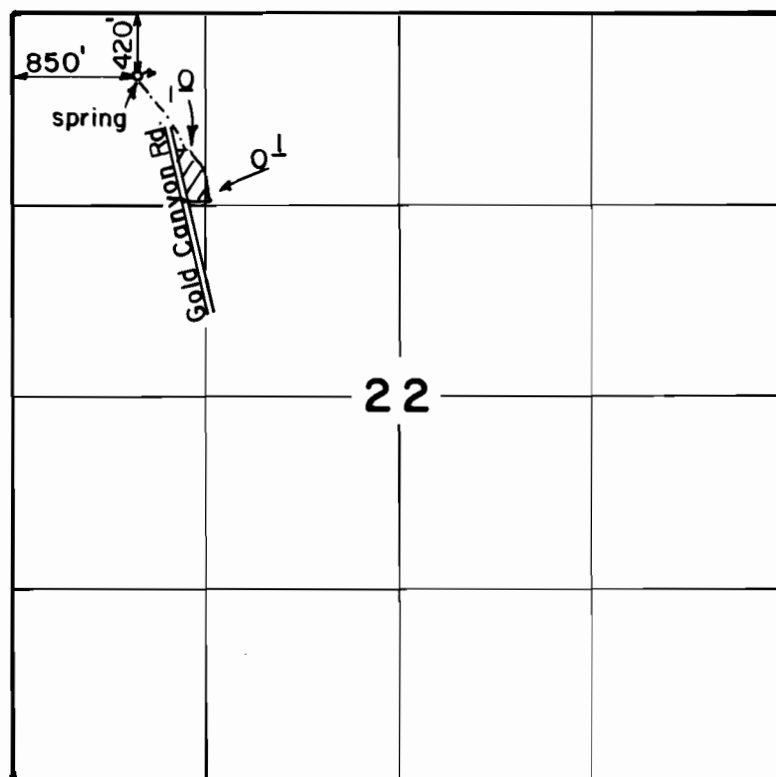

Scale: 1" = 1320'

FINAL PROOF SURVEY
UNDER

Application No. 47412 Permit No. 35218....
IN NAME OF

.....
Surveyed MAY.21.. 1990., by B.S..JAMES....