



T.4S. R.3W. W.M.

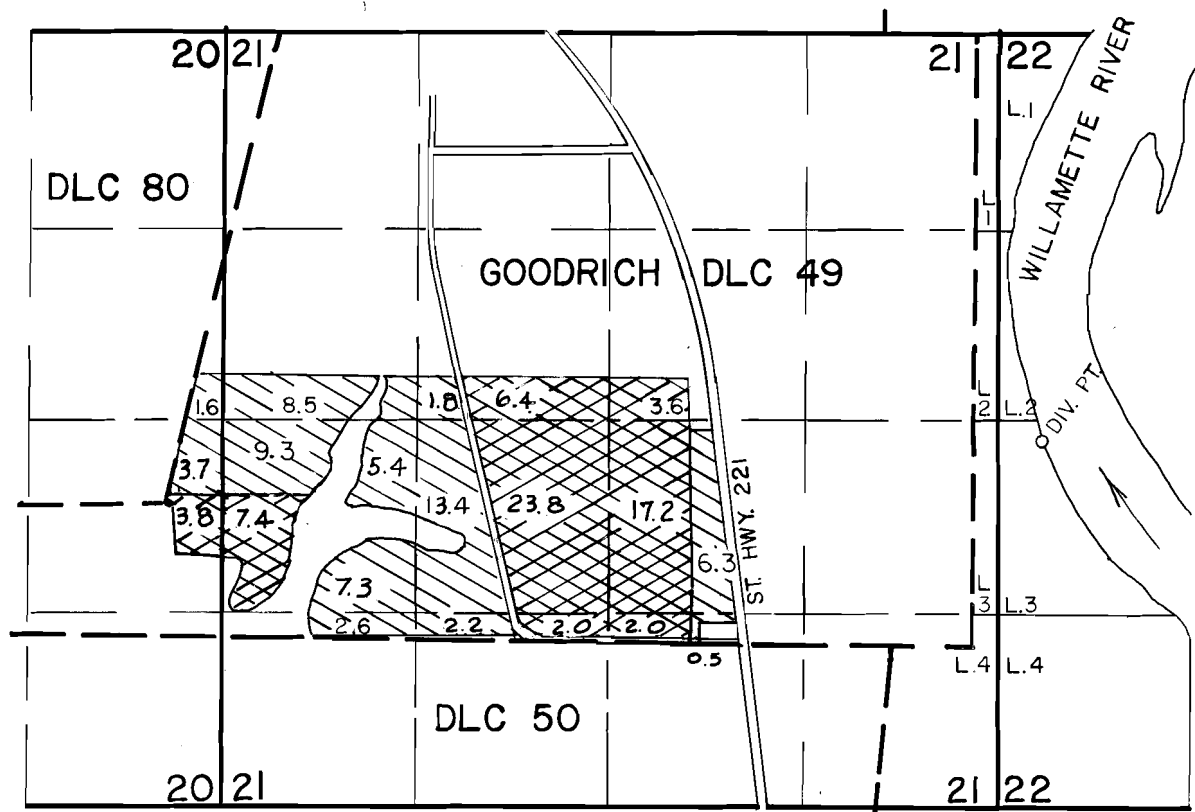

DIV. PT. LOC. 1440' N. & 450' E. FROM SE COR. GOODRICH DLC 49

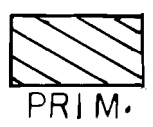

FINAL PROOF SURVEY UNDER

Application No. 55294... Permit No. 43209...
IN NAME OF

BARRY HOUSE

Surveyed MAY 16, 1984, by P.R. PAGTER