


P-42120
66828

T. 9S., R. 26E., W.M.

N

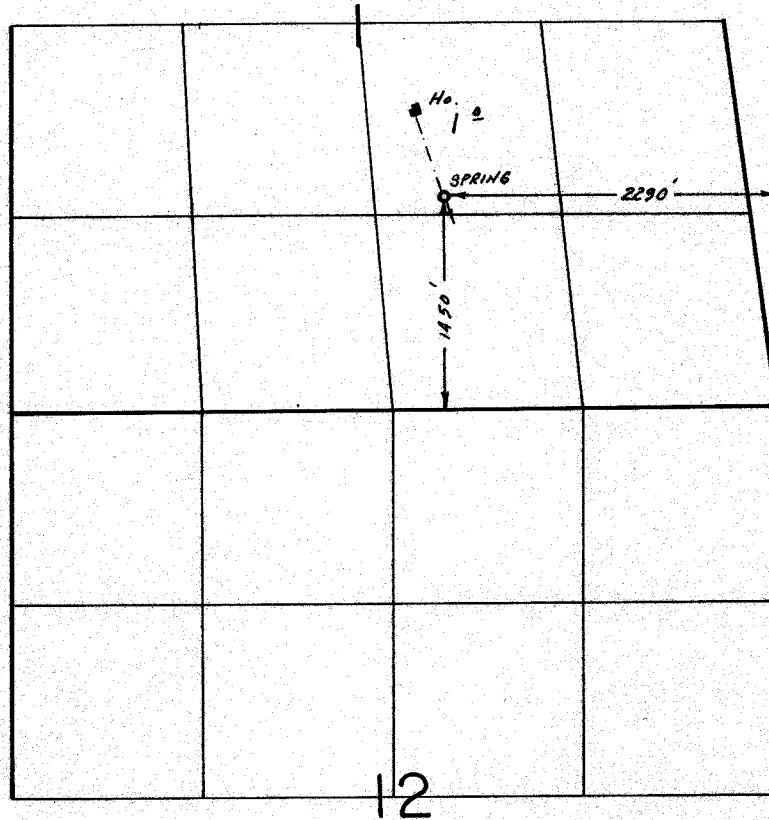

SCALE: 1" = 1320

FINAL PROOF SURVEY
UNDER

Application No. 56184.. Permit No. 42120.....
IN NAME OF

BARBARA J. & JOHN P. DAVIS.....

Surveyed June 17, 1988, by Z.F. SALEH.....

4/18/89
41023-179-60L SWB