
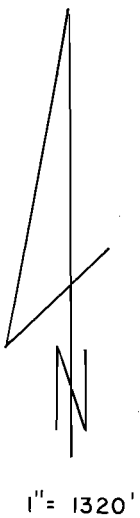


T. 26 S., R. 12 W., W.M.

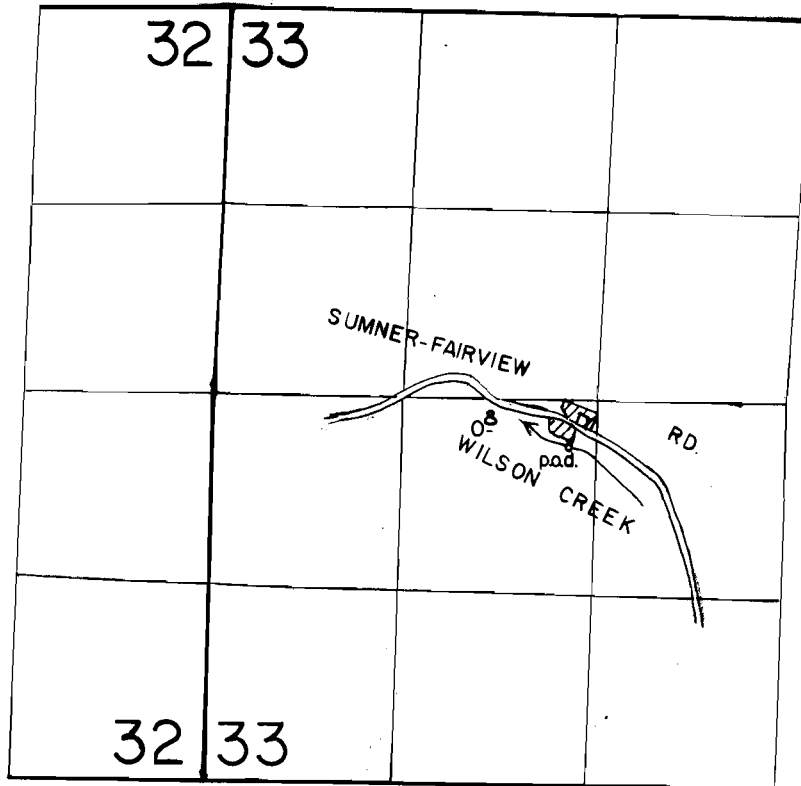

POD. LOC. 2310' N & 2450' E. SW CORNER SEC. 33

FINAL PROOF SURVEY
UNDER

Application No. 56 098 Permit No. 42 296

IN NAME OF

SHIRLEY L. SARIES

Surveyed SEPT. 17 19⁹⁰, by JC LARSON

7-30-91 DSM
41011-180-233A