


T. 37 S., R. 14 W. W.M.

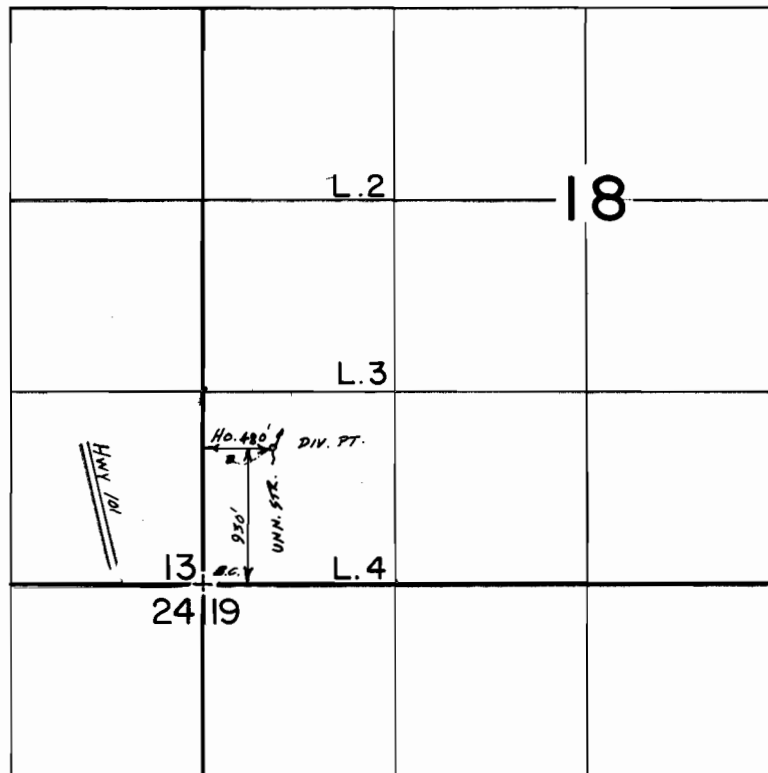

Scale 1" = 1320'

FINAL PROOF SURVEY

UNDER

Application No. 61145.... Permit No. 45537....
IN NAME OF

MARION FRANKLIN & MILDRED L. GRINDSTAFF

Surveyed July 28, 1989, by B.S. JAMES.....
June 4, 1990