


T. 41 S., R. 9 W., W. M.

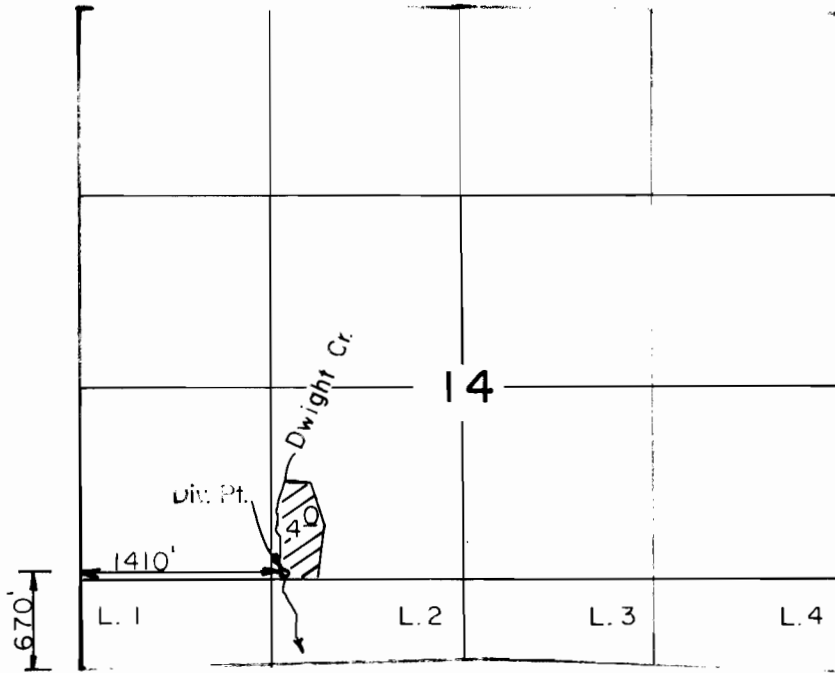

CALIFORNIA

Scale: 1" = 1320'

FINAL PROOF SURVEY UNDER

Application No. 61879. Permit No. 46477...
IN NAME OF

.....BURDETTE W. HANCOCK.....

Surveyed APR..II.... 1988., by B. S. JAMES.....