


V-41194

66839

T.8&9S., R.25E., W.M

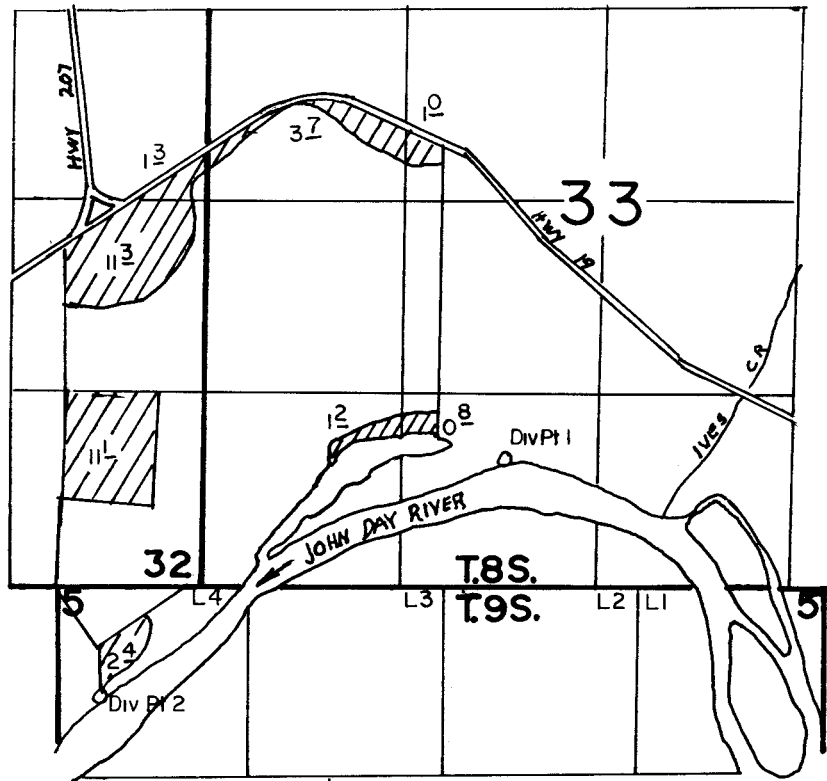

DIV. PT.1 LOCATED 900' N. & 3060' E. FROM NW COR SEC 5
 DIV. PT.2 LOCATED 750' S & 300' E FROM NW COR SEC 5

SCALE: 1" = 1320'

FINAL PROOF SURVEY UNDER

Application No. 65056... Permit No. 477.94.....
 IN NAME OF
Michael W Epton,
Nolan P. Milburn & Darrell G. Davis...
 Surveyed MAY...14... 1987... by V.L. CHURCH.....