


T. 38 S., R. 7 W., W. M.

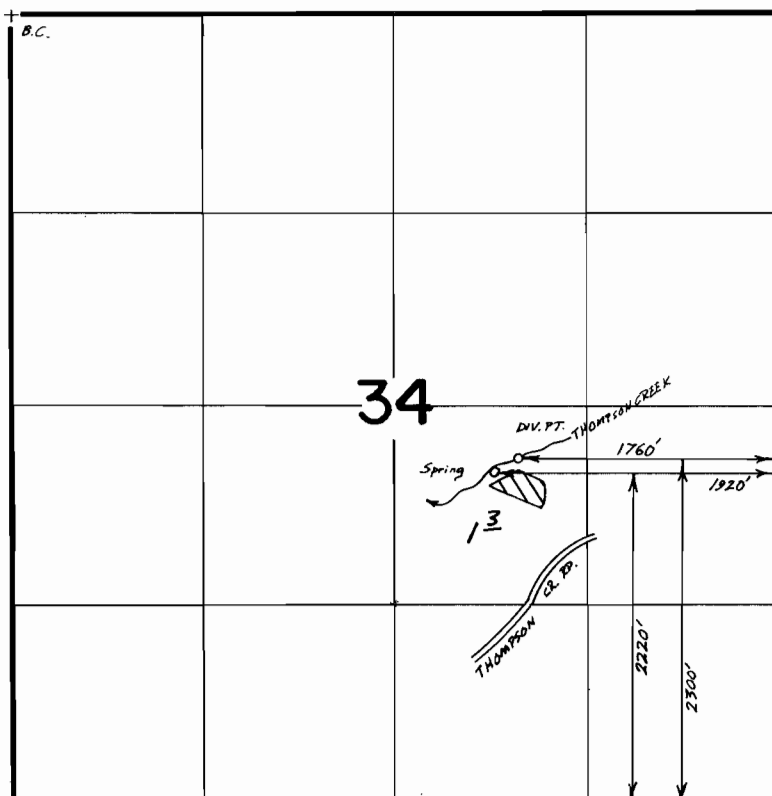

Scale 1" = 1320'

FINAL PROOF SURVEY UNDER

Application No. 65243 Permit No. 47885
IN NAME OF

JEWEL L. McATEE

Surveyed June 4, 1986, by B.S. JAMES