


T. 38 S., R. 8 W., W. M.

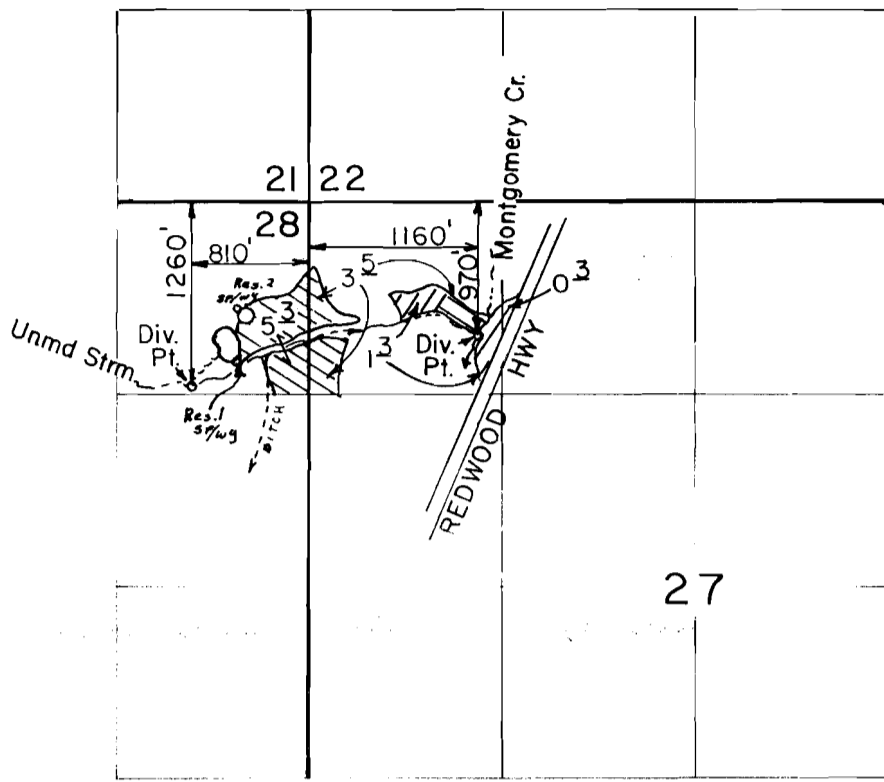

Scale: 1" = 1320'

PRIMARY 

SUPPLEMENTAL 

**FINAL PROOF SURVEY**  
UNDER

R-65571 R-9396

Application No. 65572, Permit No. 48270....  
IN NAME OF

**MARK WICKERS & DEAN DRAGES**

Surveyed MAY 30, 1990, by B. S. JAMES...

1033-199-230R  
5/91 LMS