


T. 38 S., R. 8 W., W. M.

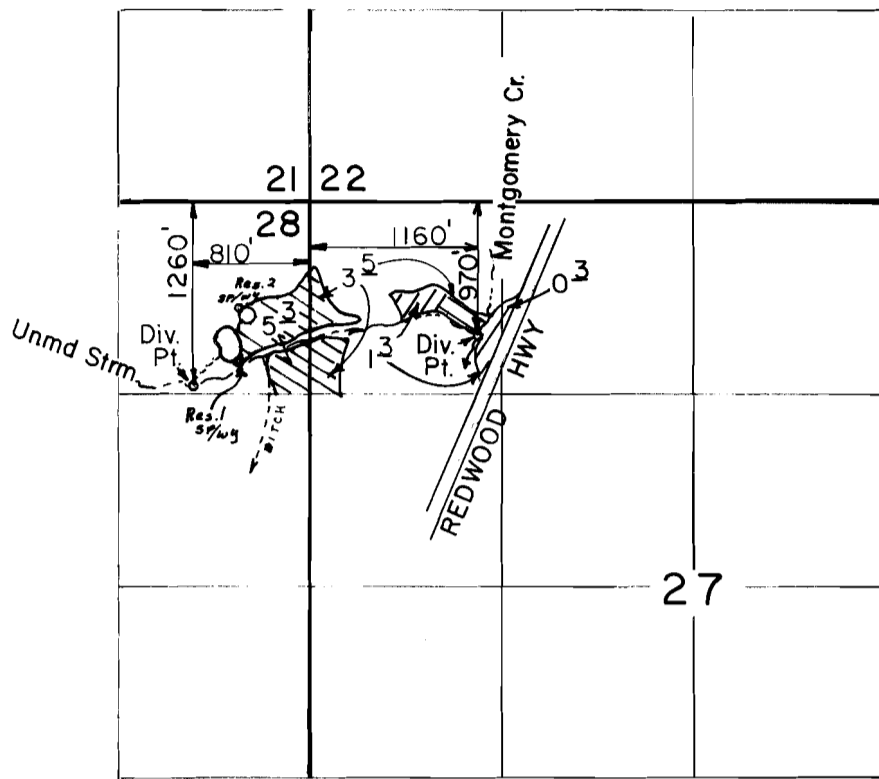

Scale: 1" = 1320'

PRIMARY

SUPPLEMENTAL

FINAL PROOF SURVEY
UNDER

R-65571 R-9396

Application No. 65572. Permit No. 48270....
IN NAME OF

MARK...WICKERS & DEAN...DRAGES

Surveyed MAY. 30. 1990., by B. S. JAMES...

1033-199-230R
5/91 LMS