


F-48180

C-66844

T. 12 & 13 S. R. 26 E. W.M.



Scale 1"=1320'

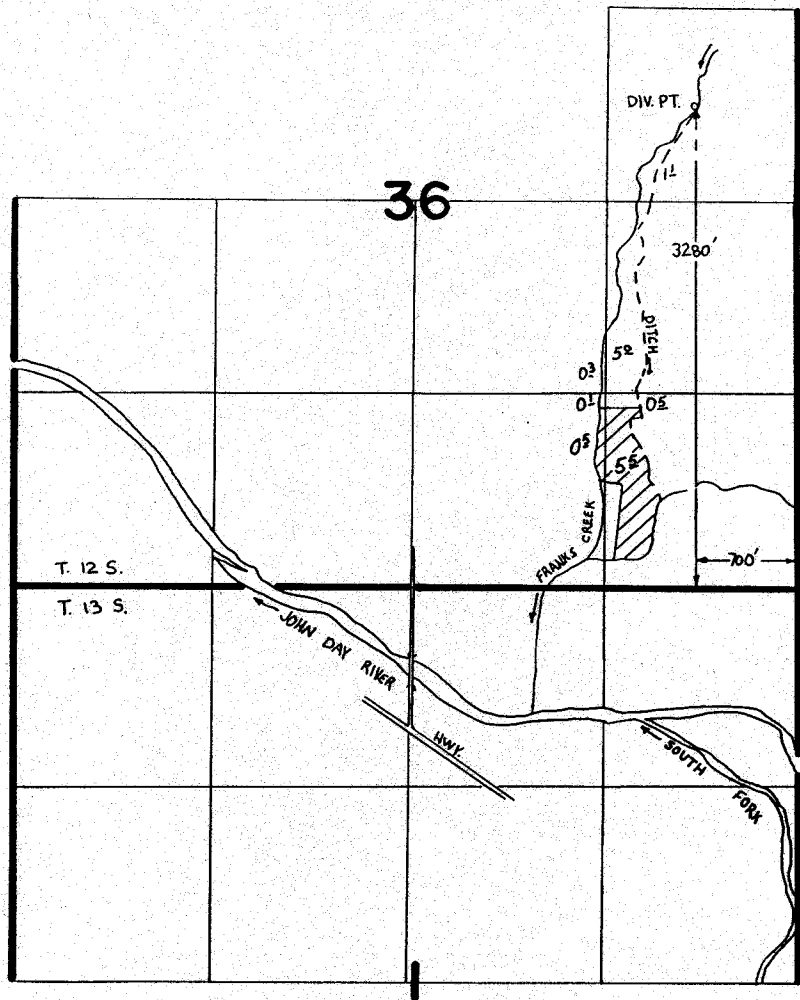

FINAL PROOF SURVEY UNDER

Application No. 67104... Permit No. 48180.....
IN NAME OF

LOUIS E. MARKS

Surveyed April 24, 1986, by V. Church.....