


T. 29 S., R. 4 W., W. M.

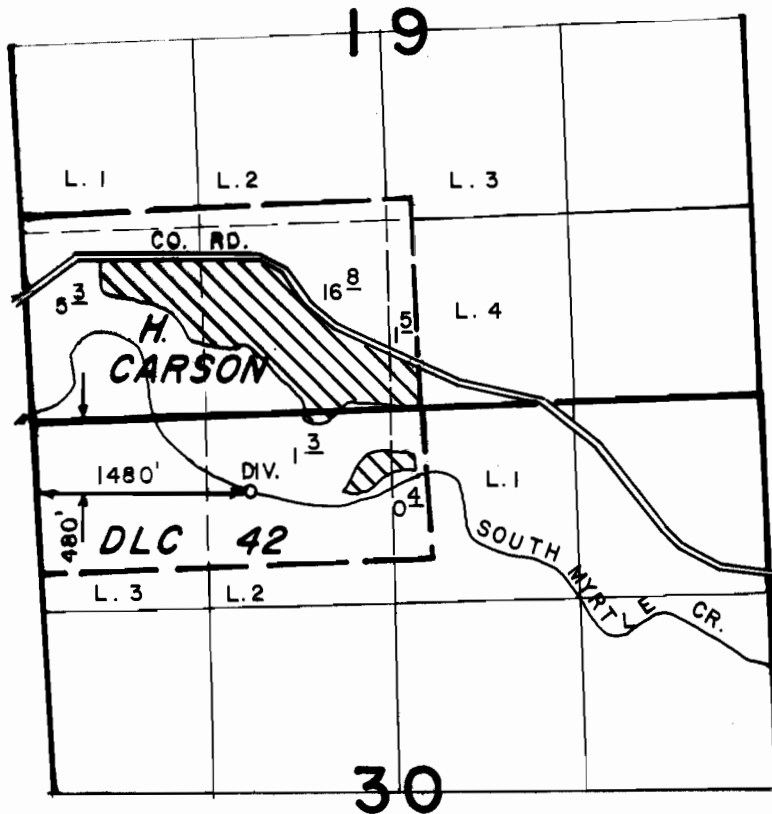

SCALE: 4" = 1 MILE

FINAL PROOF SURVEY
UNDER

Application No. 68000 Permit No. 48286
IN NAME OF

ROY L. ANDERSON

Surveyed SEPT. 30 1988, by J.M. SCHMORDE