


T. 36 S., R. 4 W., W. M.

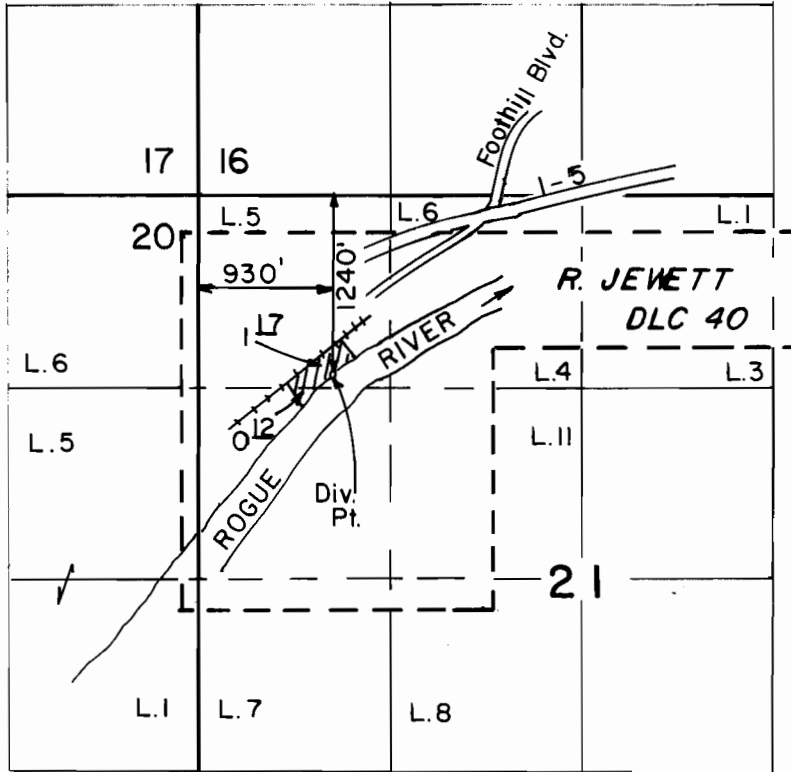

Scale: 1" = 1320'

FINAL PROOF SURVEY UNDER

Application No. 68300 Permit No. 49271
IN NAME OF

DAVID G. THOMAS

Surveyed JUL. 16. 1990., by L. M. JOACHIMS.