


T. 38 S., R. 6 & 7 W., W.M.

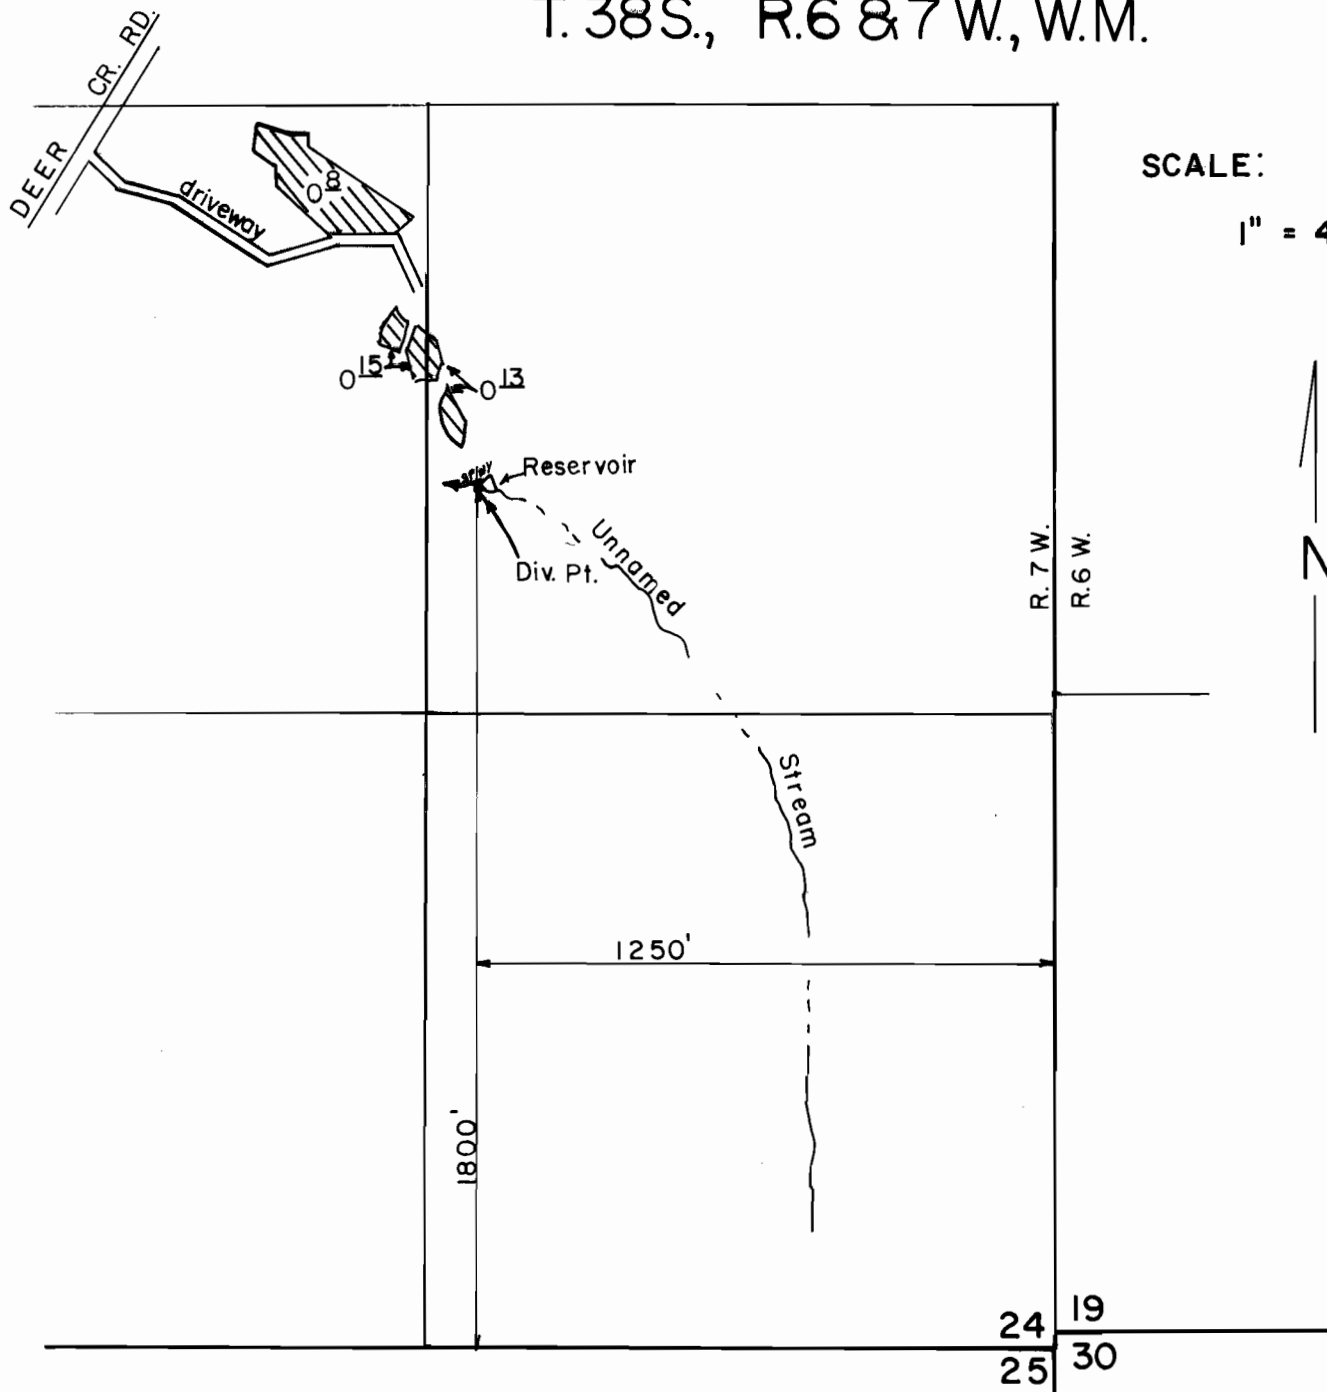

FINAL PROOF SURVEY

UNDER

R-68852

R-10816

Application No. ~~6.8853~~ Permit No. ~~4.9910~~.....

IN NAME OF

ANDREA.....BRINKMAN-GIORDANO

Surveyed OCT. 31, 1990, by B. S. JAMES.....