




FINAL PROOF SURVEY MAP
IN THE NAME OF ROSE ADAIR

SECTION 2, T23S, R6W, W.M.

APPLICATION R-69458

PERMIT R-11035

SCALE: 1 INCH = 1320 FEET

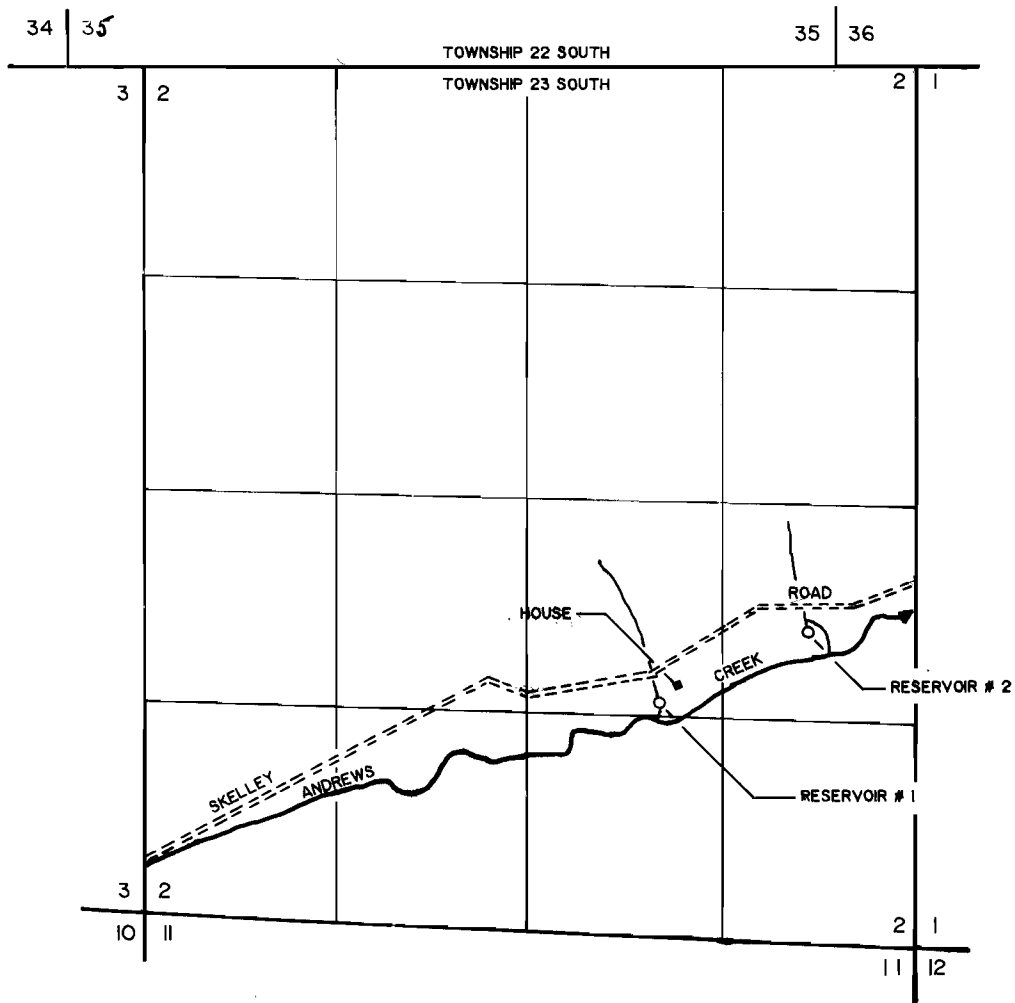

THE PURPOSE OF THIS MAP IS TO IDENTIFY THE LOCATION OF THE WATER RIGHT. IT IS NOT INTENDED TO PROVIDE INFORMATION RELATIVE TO THE LOCATION OF PROPERTY OWNERSHIP BOUNDARY LINES.

