



T. 32 S. R. 15 W. W.M.

MAP 36 1931
1931

LEGEND:  HEAT CONTROL = 0.84 AC (NW NW) 1.2 AC (NE NW) = 2.04 AC

 TERR. TEMP CONTROL, FLOOD HARVEST = 1.35 AC

 FLOOD HARVEST, HEAT CONTROL = 1.94 AC.

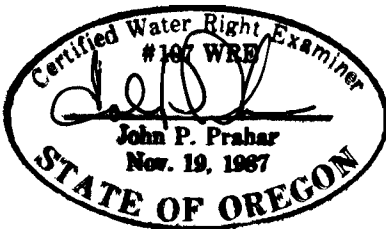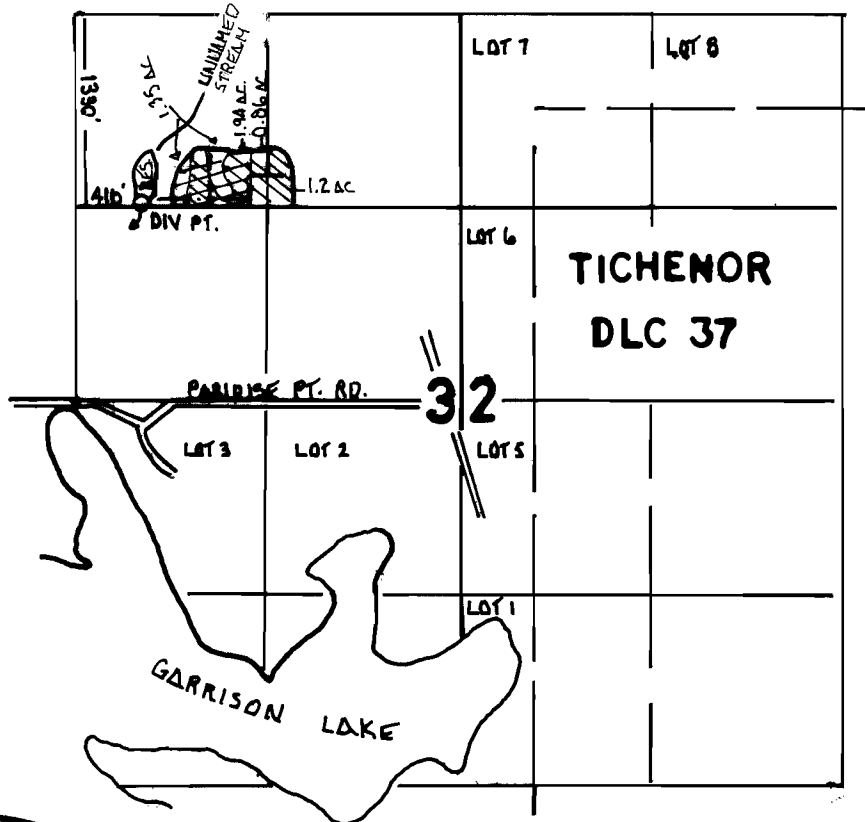

SCALE 4" = 1 MILE

FINAL PROOF SURVEY UNDER

APPLICATION
R69488/69489

PERMIT
R.W56/50732

IN NAME OF

DARYL C. AND ADELLA J. ROBISON

SURVEYED AUG. 22, 1990, CWRE 107

THE PREPERATION OF THIS MAP IS TO IDENTIFY THE LOCATION OF THE WATER RIGHT ONLY. THIS MAP HAS NO INTENT ON SURVEY DIMENSIONS OR OWNERSHIP LINES.


CWRE # 107