
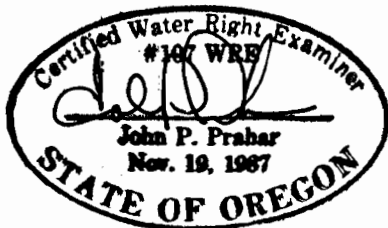


T. 32 S. R. 15 W. W.M.

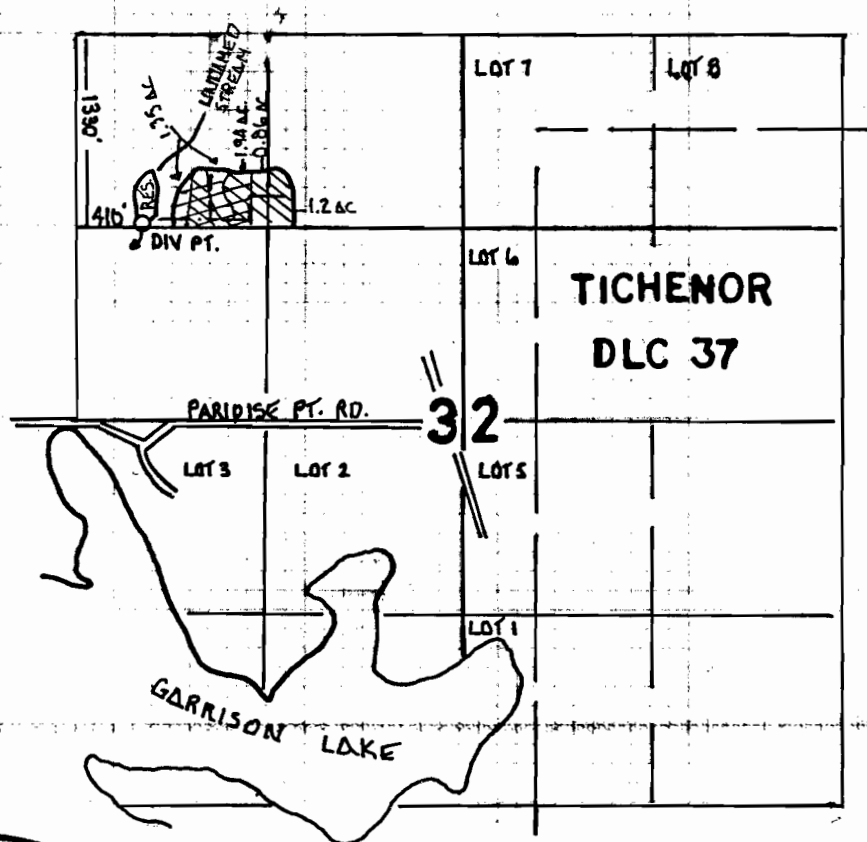

SCALE 4" = 1 MILE

FINAL PROOF SURVEY UNDER

APPLICATION
R69488/69489

PERMIT
R.W.56/50732

IN NAME OF

DARYL C. AND ADELLA J. ROBISON

SURVEYED AUG. 22, 1990, CWRE 107