
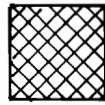
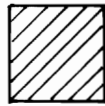


T. 37 S., R. 2 E., W.M.

AREA IRRIGATED BY
T-6051

PORTION OF T-3970
BEING TRANSFERED

PORTION OF T-3970
NOT MODIFIED BY
BY T-6051

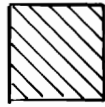

FINAL PROOF MAP



TRANSFER No. T-6051

IN THE NAME OF

FRANK L. BROWN

MAP PREPARED OCTOBER 10, 1994

BY GARY D. KAISER

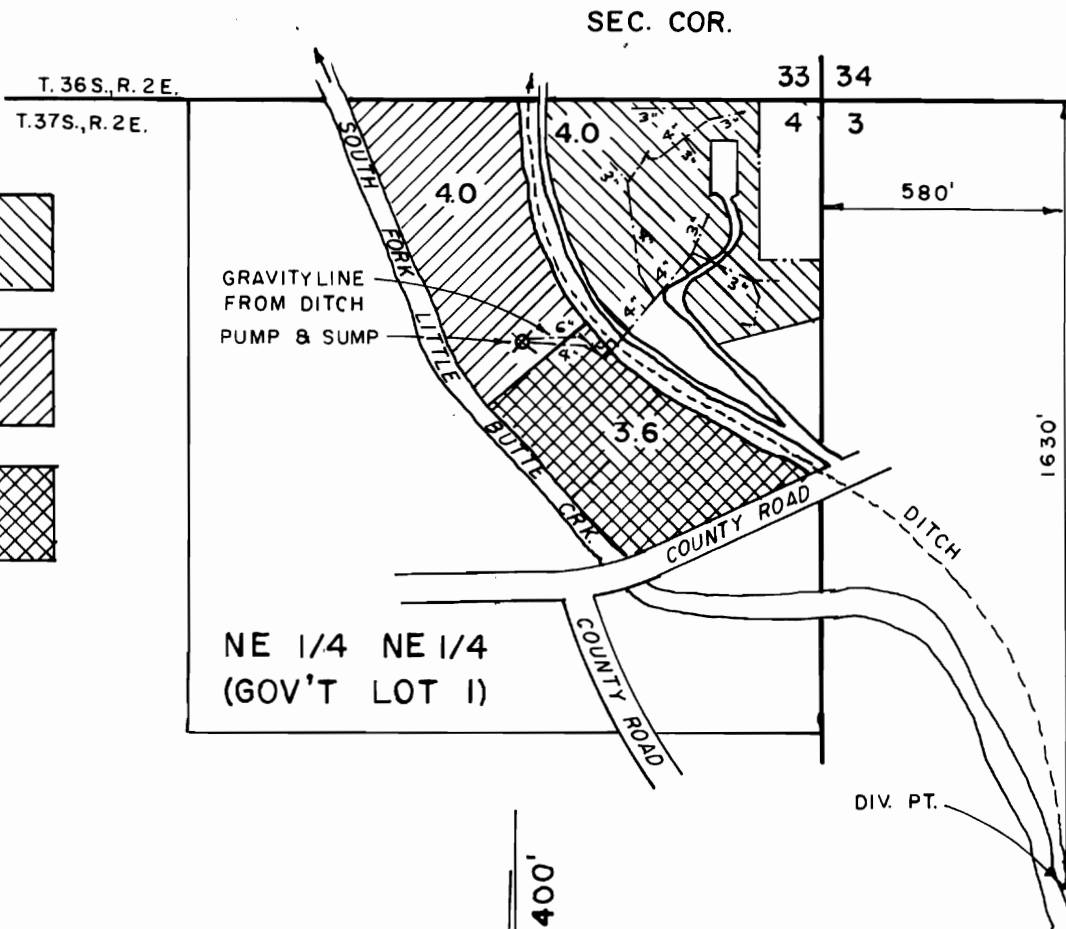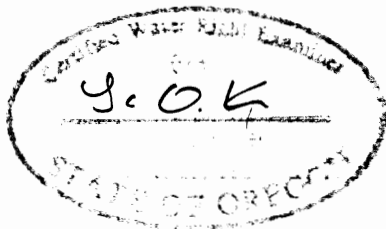

SCALE: 1" = 400'

NOTE: MAP PREPARED FOR
WATER RIGHT PURPOSES ONLY,
NOT FOR PROPERTY BOUNDARY
LOCATIONS.