


T.38&4N.R.1&2W.W.M.

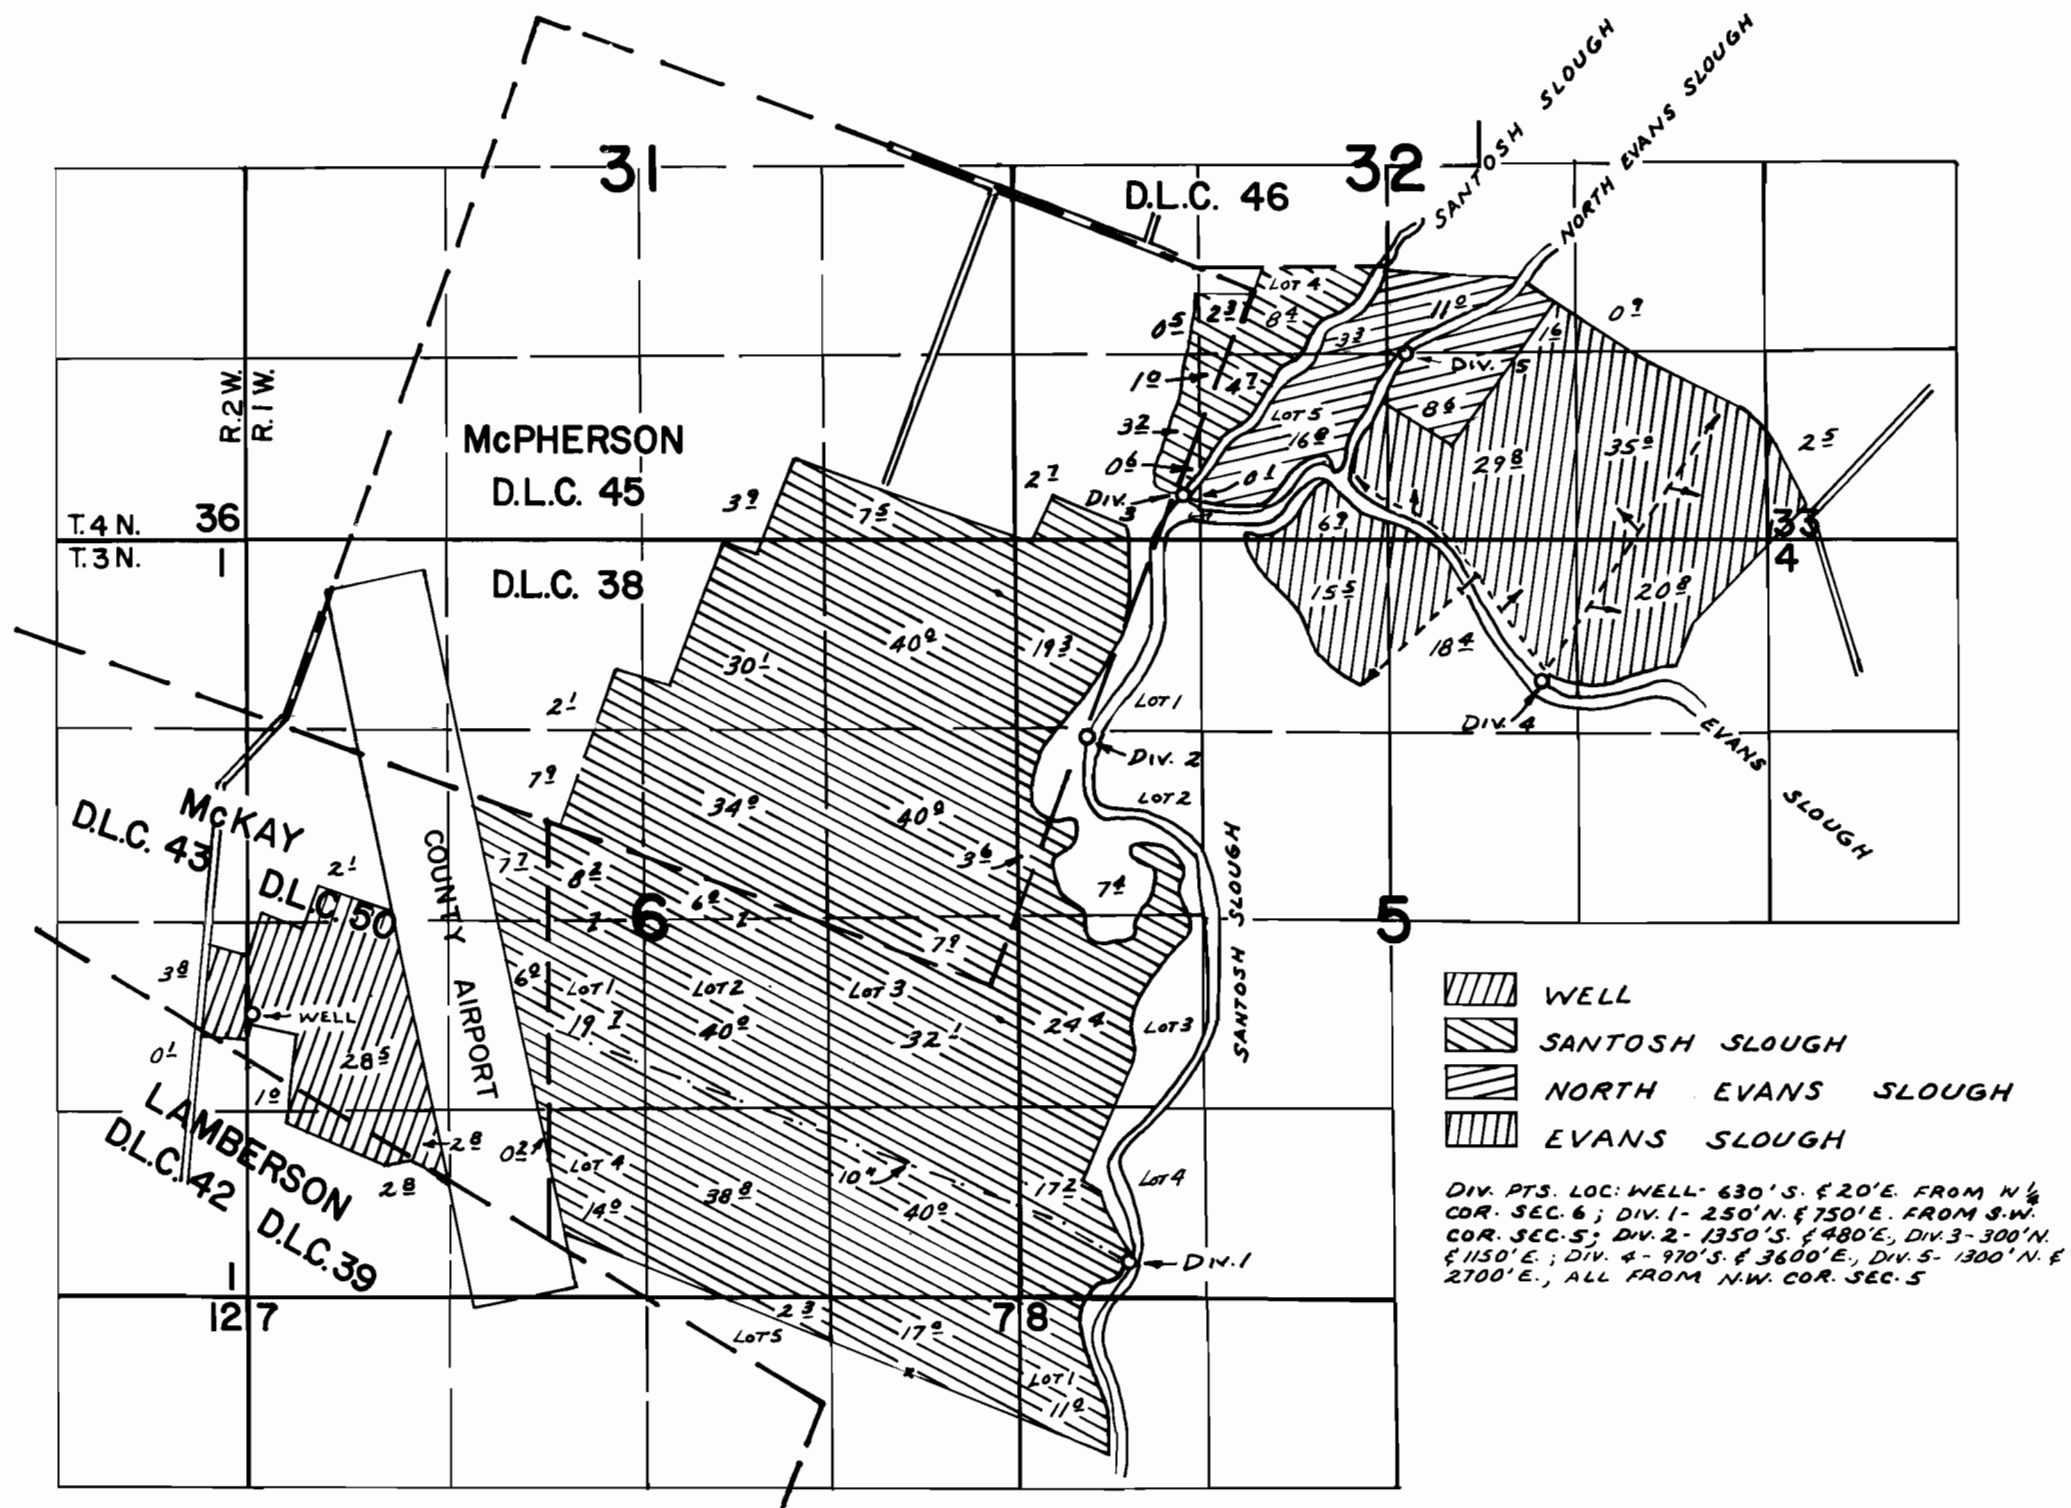

FINAL PROOF SURVEY

APPLICATION NO. 49125 PERMIT NO. 35836
G-5763 G-5258

In Name Of

DONALD R. MEIER

Surveyed May 7, 1980 By R. Mucken