


T.38&4N.R.18&2W.W.M.

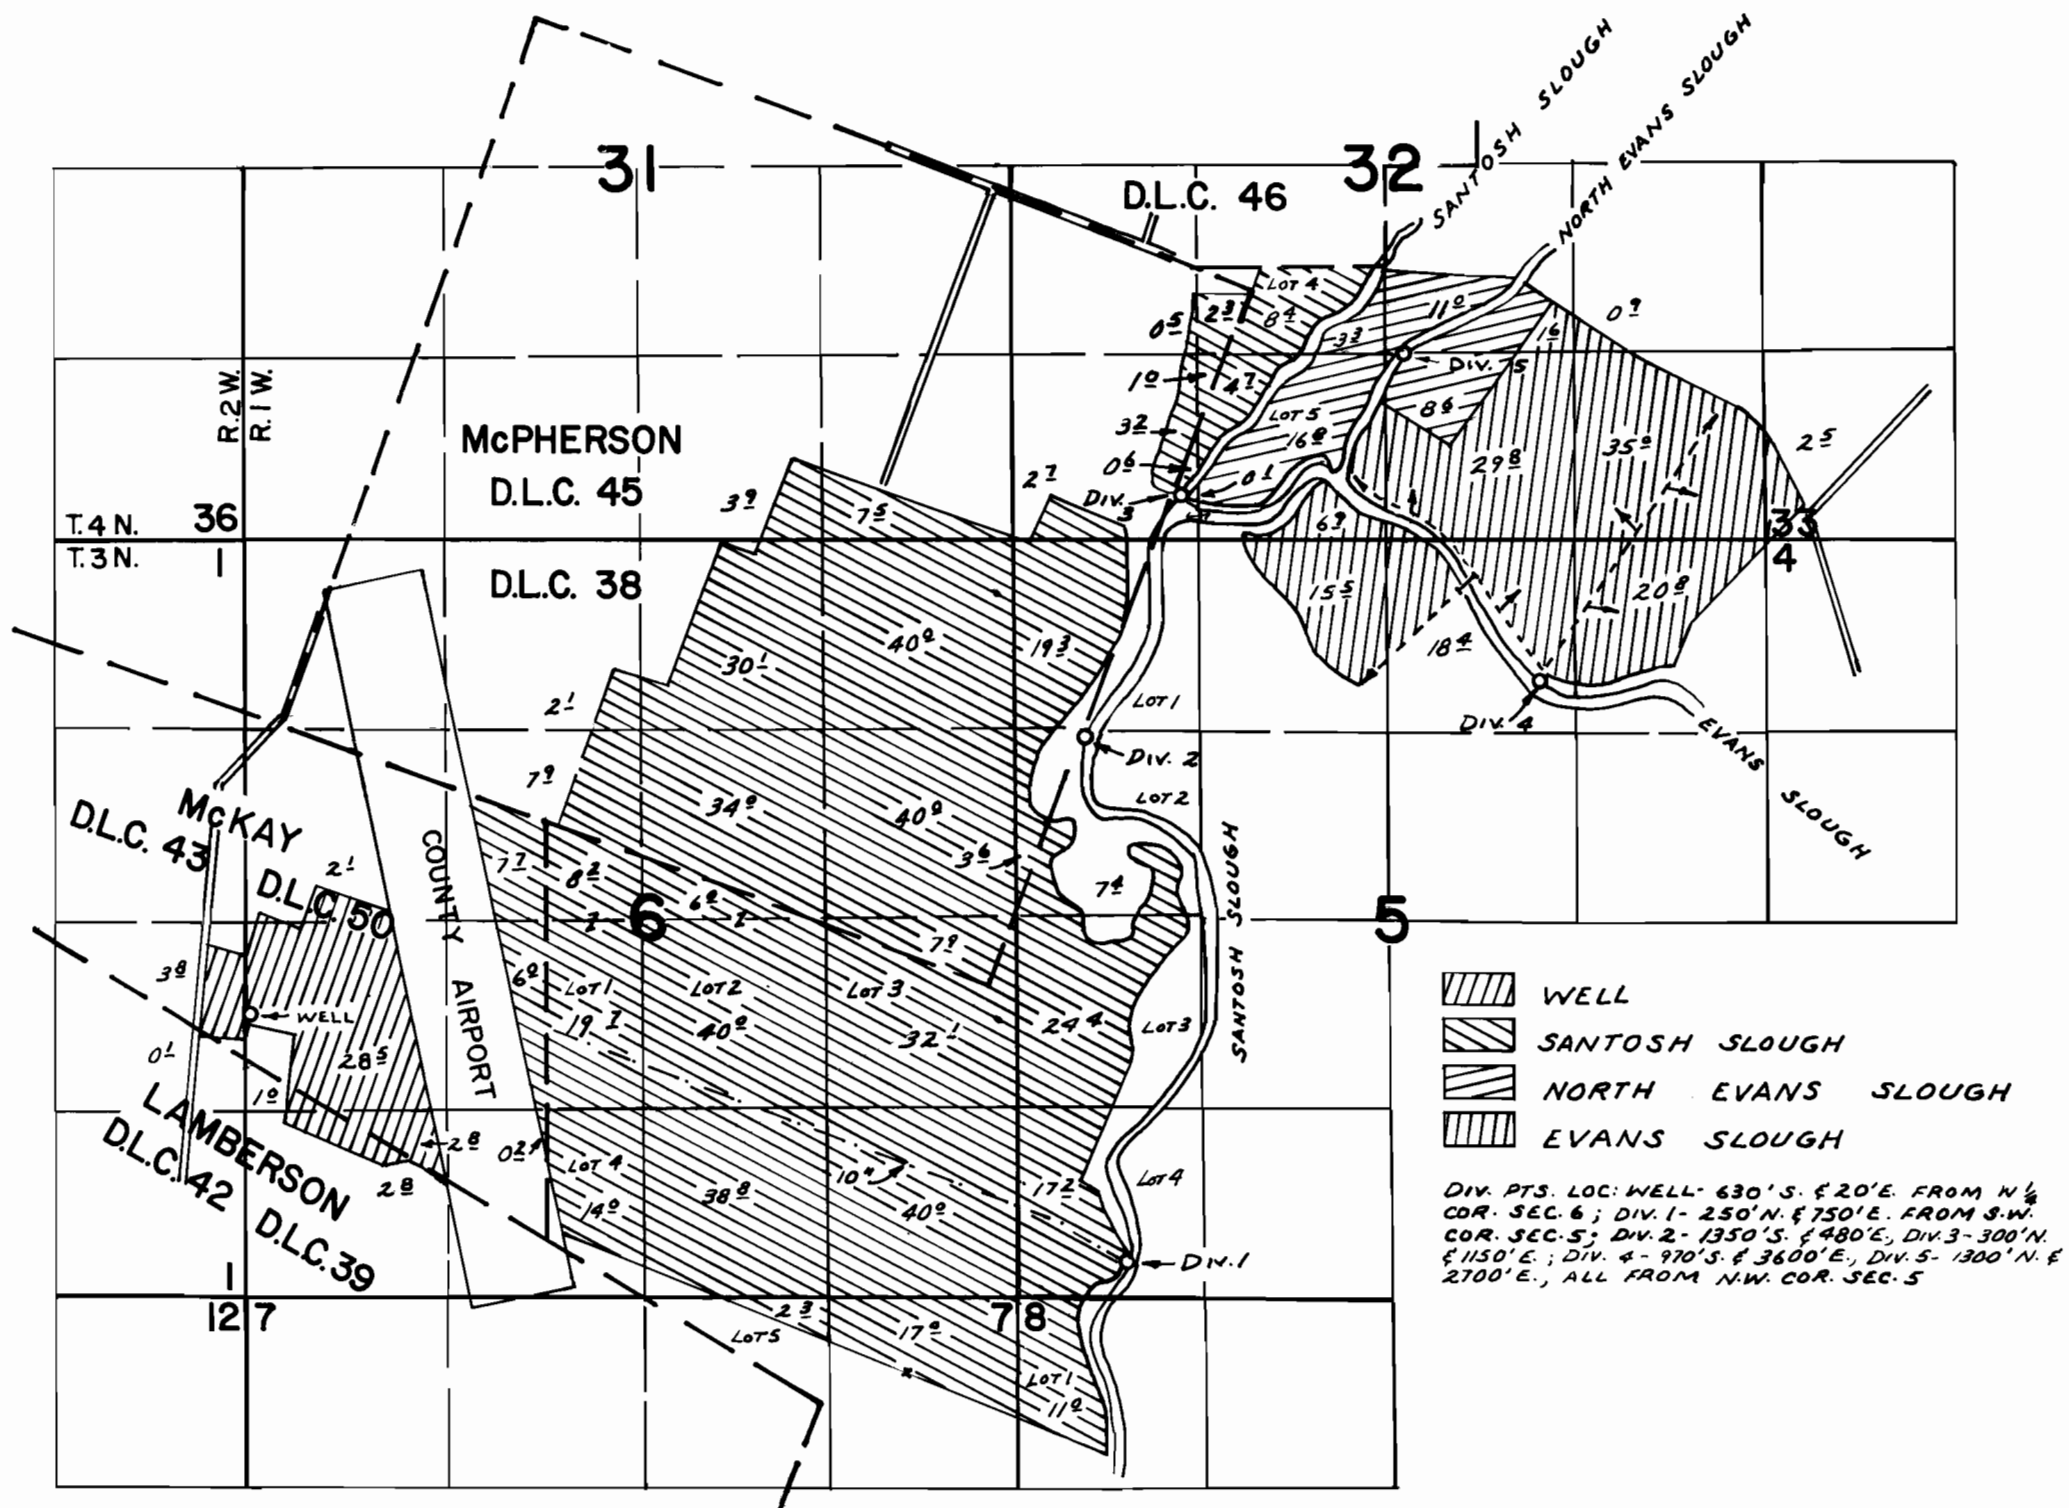

**FINAL PROOF SURVEY**

APPLICATION NO. 49125 PERMIT NO. 35836  
G-5763 G-5258

In Name Of

DONALD R. MEIER

Surveyed May 7, 1980 By R. Mucken