


T.17 S., R. 23 E., W.M.

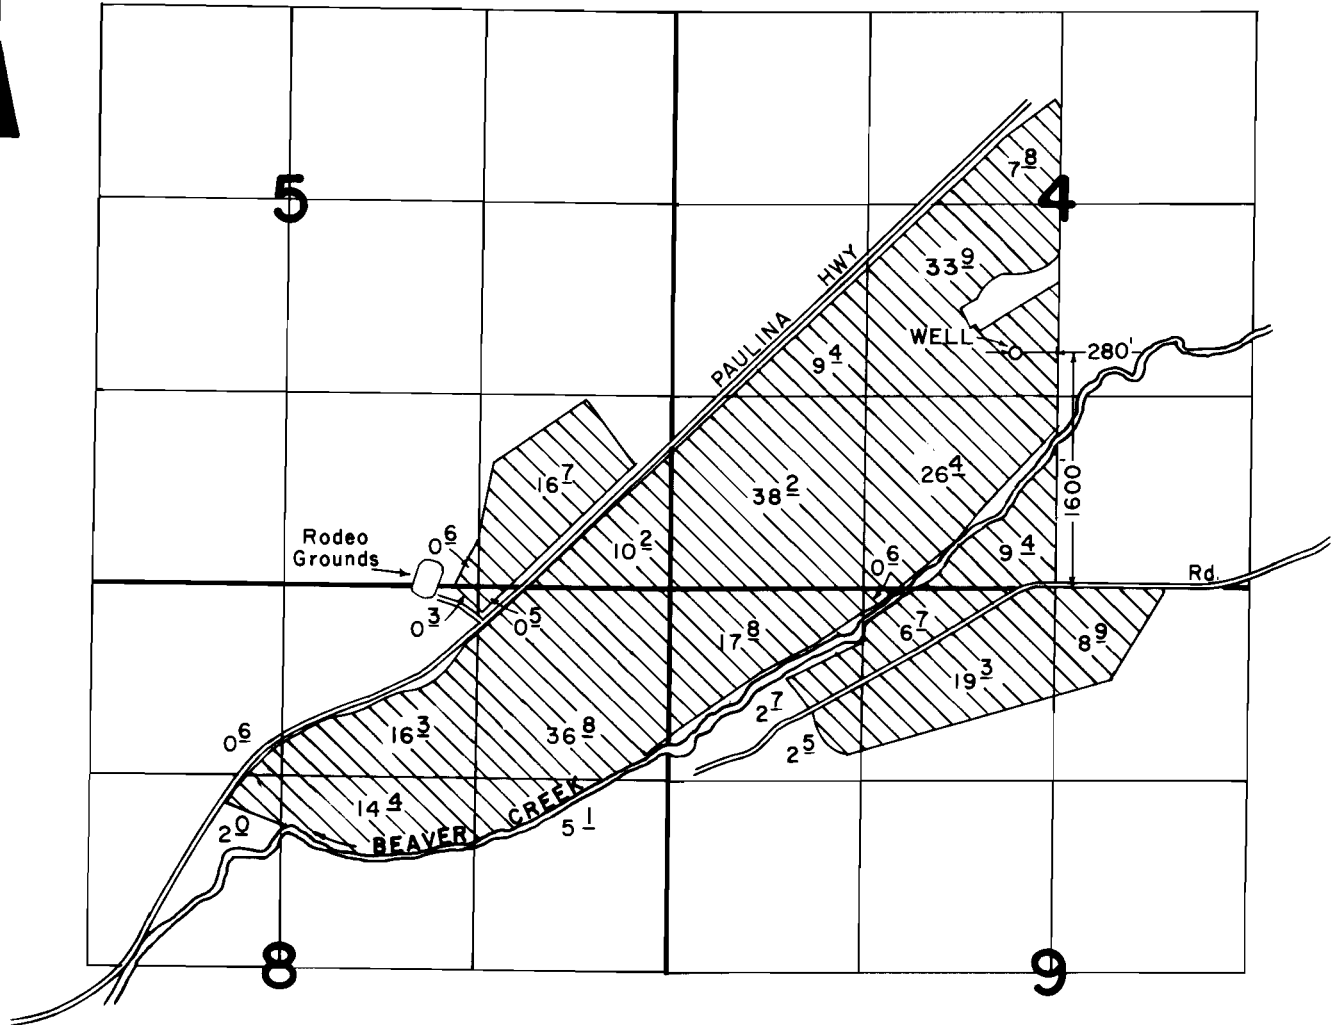

SCALE: 1" = 1320'

FINAL PROOF SURVEY
UNDER

Application No. G-5825 Permit No. G-5468...
IN NAME OF

GEORGE E & HELEN M. PERRIN

Surveyed JAN. 23 1990, by B. W. BISHOP...
APR 29 1991

REVISED 8/22/91 BuB

6-12-90

41013-280-49D