


T. 38 S., R. 8 W., W. M.

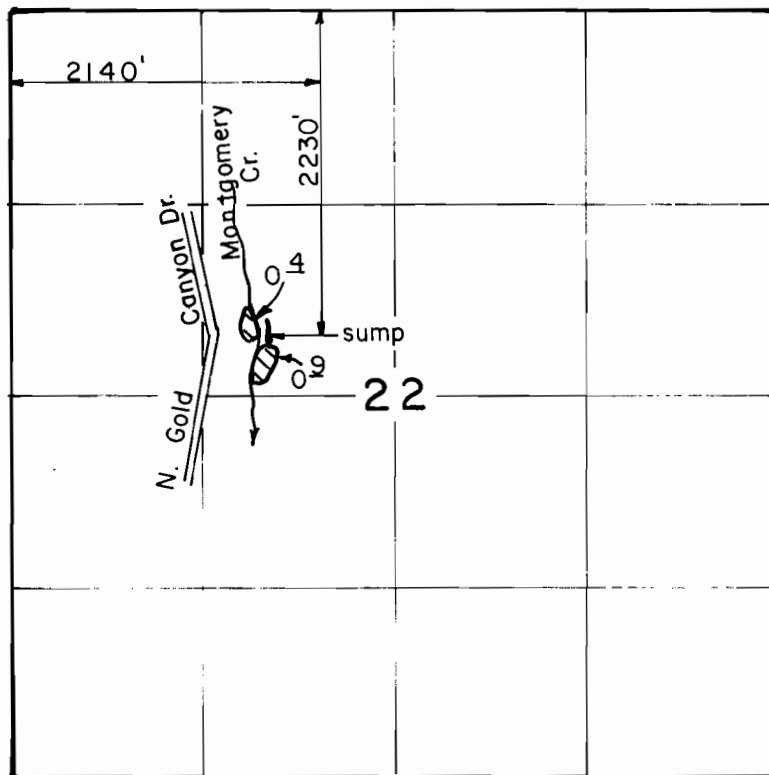

Scale: 1" = 1320'

FINAL PROOF SURVEY
UNDER

Application No. G-6696 Permit No. G-6242...
IN NAME OF

DAWN RAINRABBIT & SUMA SHAAZ MUNDA

Surveyed APR. 18. 1988., by B.S. JAMES...