


T. 40S., R. 11E., W.M.

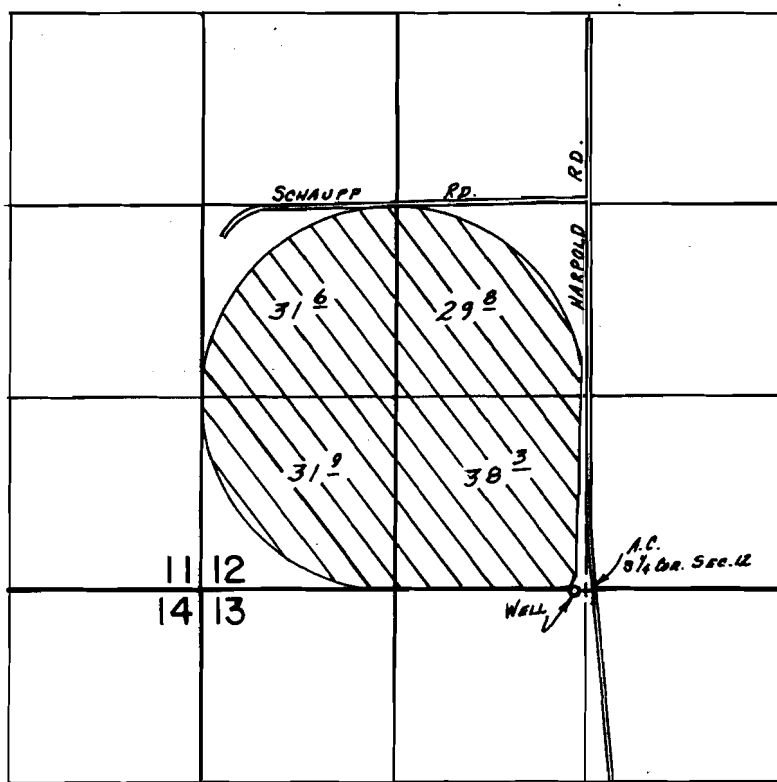

WELL LOC: 50' W. FROM S 1/4 COR. SEC. 12



Post River Wells

SCALE: 1" = 1320'

FINAL PROOF SURVEY UNDER

Application No. G-8983 [REDACTED]
IN NAME OF

CARL RAJNUS

Surveyed July 13, 1990, by D. SPARKS