


66864

T.14S., R.13E., W.M.

SECTION 16

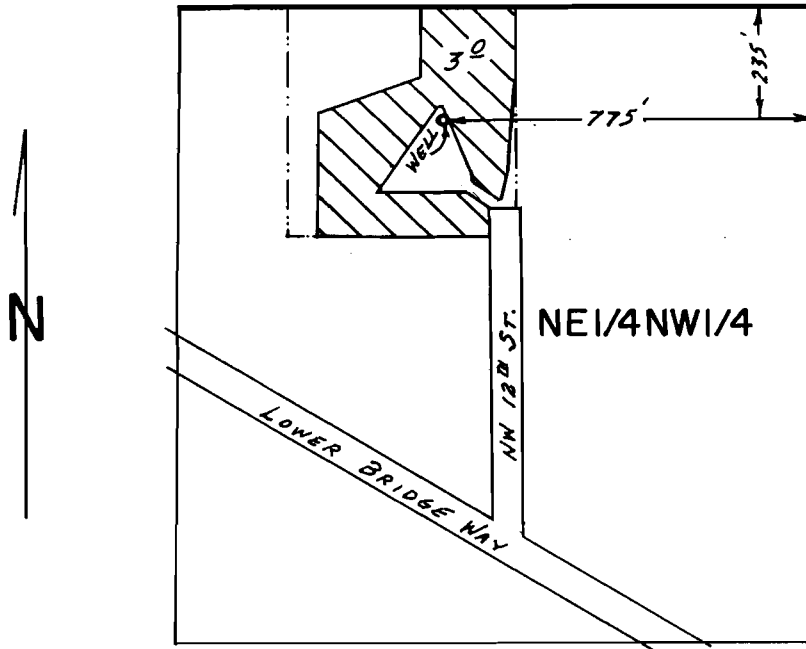

SCALE: 1" = 400'

FINAL PROOF SURVEY UNDER

Application No. G-9550 Permit No. G-8758...
IN NAME OF

Cert. 66864

.....CECIL E. PETERS.....

Surveyed Oct. 10, 1983, by D. PANTHER...
Feb. 11, 1991, B.W. BISHOP

Rec'd 12-13-91
WD#-11

2/25/91
PTS 11-1983A & CHAIN B.W.B.

G 8758