


G-9471
66865



T. 26 S., R. 15 E., W.M.

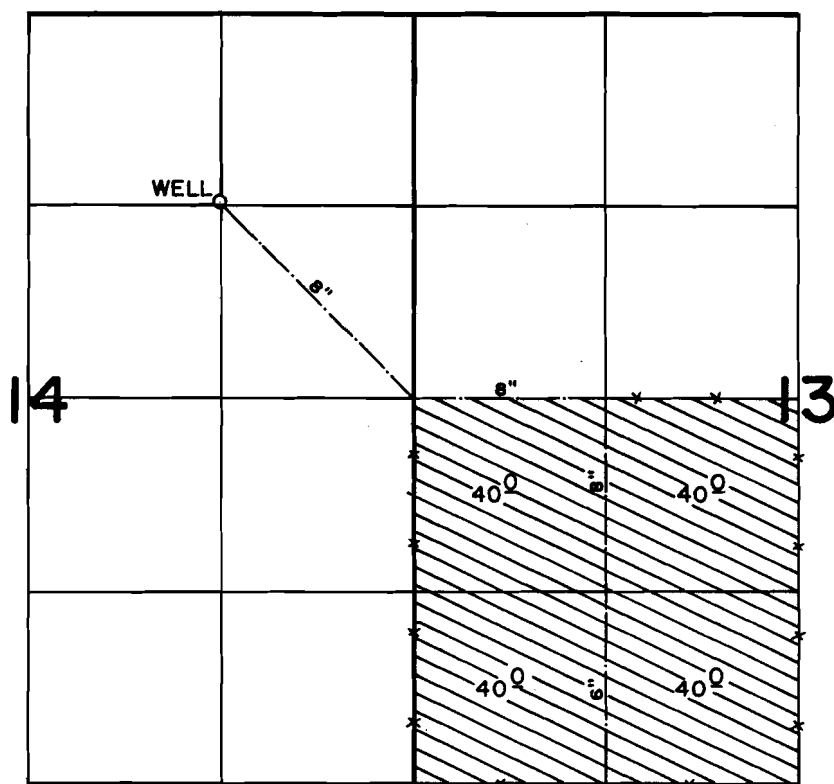

WELL LOC.: 1340' N. & 1340' W. FROM E. 1/4 CORNER SECTION 14

SCALE: 1" = 1320'

FINAL PROOF SURVEY
UNDER

Application No. G-10397 Permit No. G-9471.....
IN NAME OF Cert# 66865

LOMA VISTA FARMS, INC.....

Surveyed JULY 13, 1989, by B.W. BISHOP.....