


T. 28 S., R. 14 W., W.M.

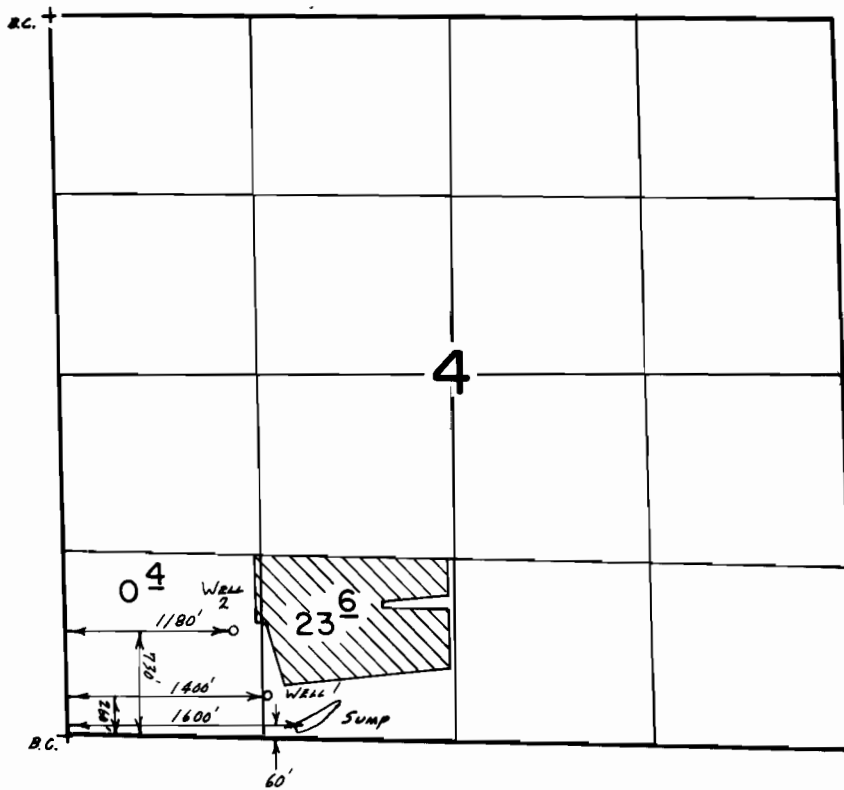

Scale 1"=1320'

FINAL PROOF SURVEY UNDER

Application No. G-11427 Permit No. G-10543
IN NAME OF

RONALD F. or WANDA J. KASPER

Surveyed June 20, 1990, by B.S. James.....