


ROSEWOOD ACRE TRACTS

Platted By
 The Oregon Iron & Steel Co.
 SURVEYED BY - D. THOMPSON MELDRUM.
 1912.

App- 9290
 Per- 6140

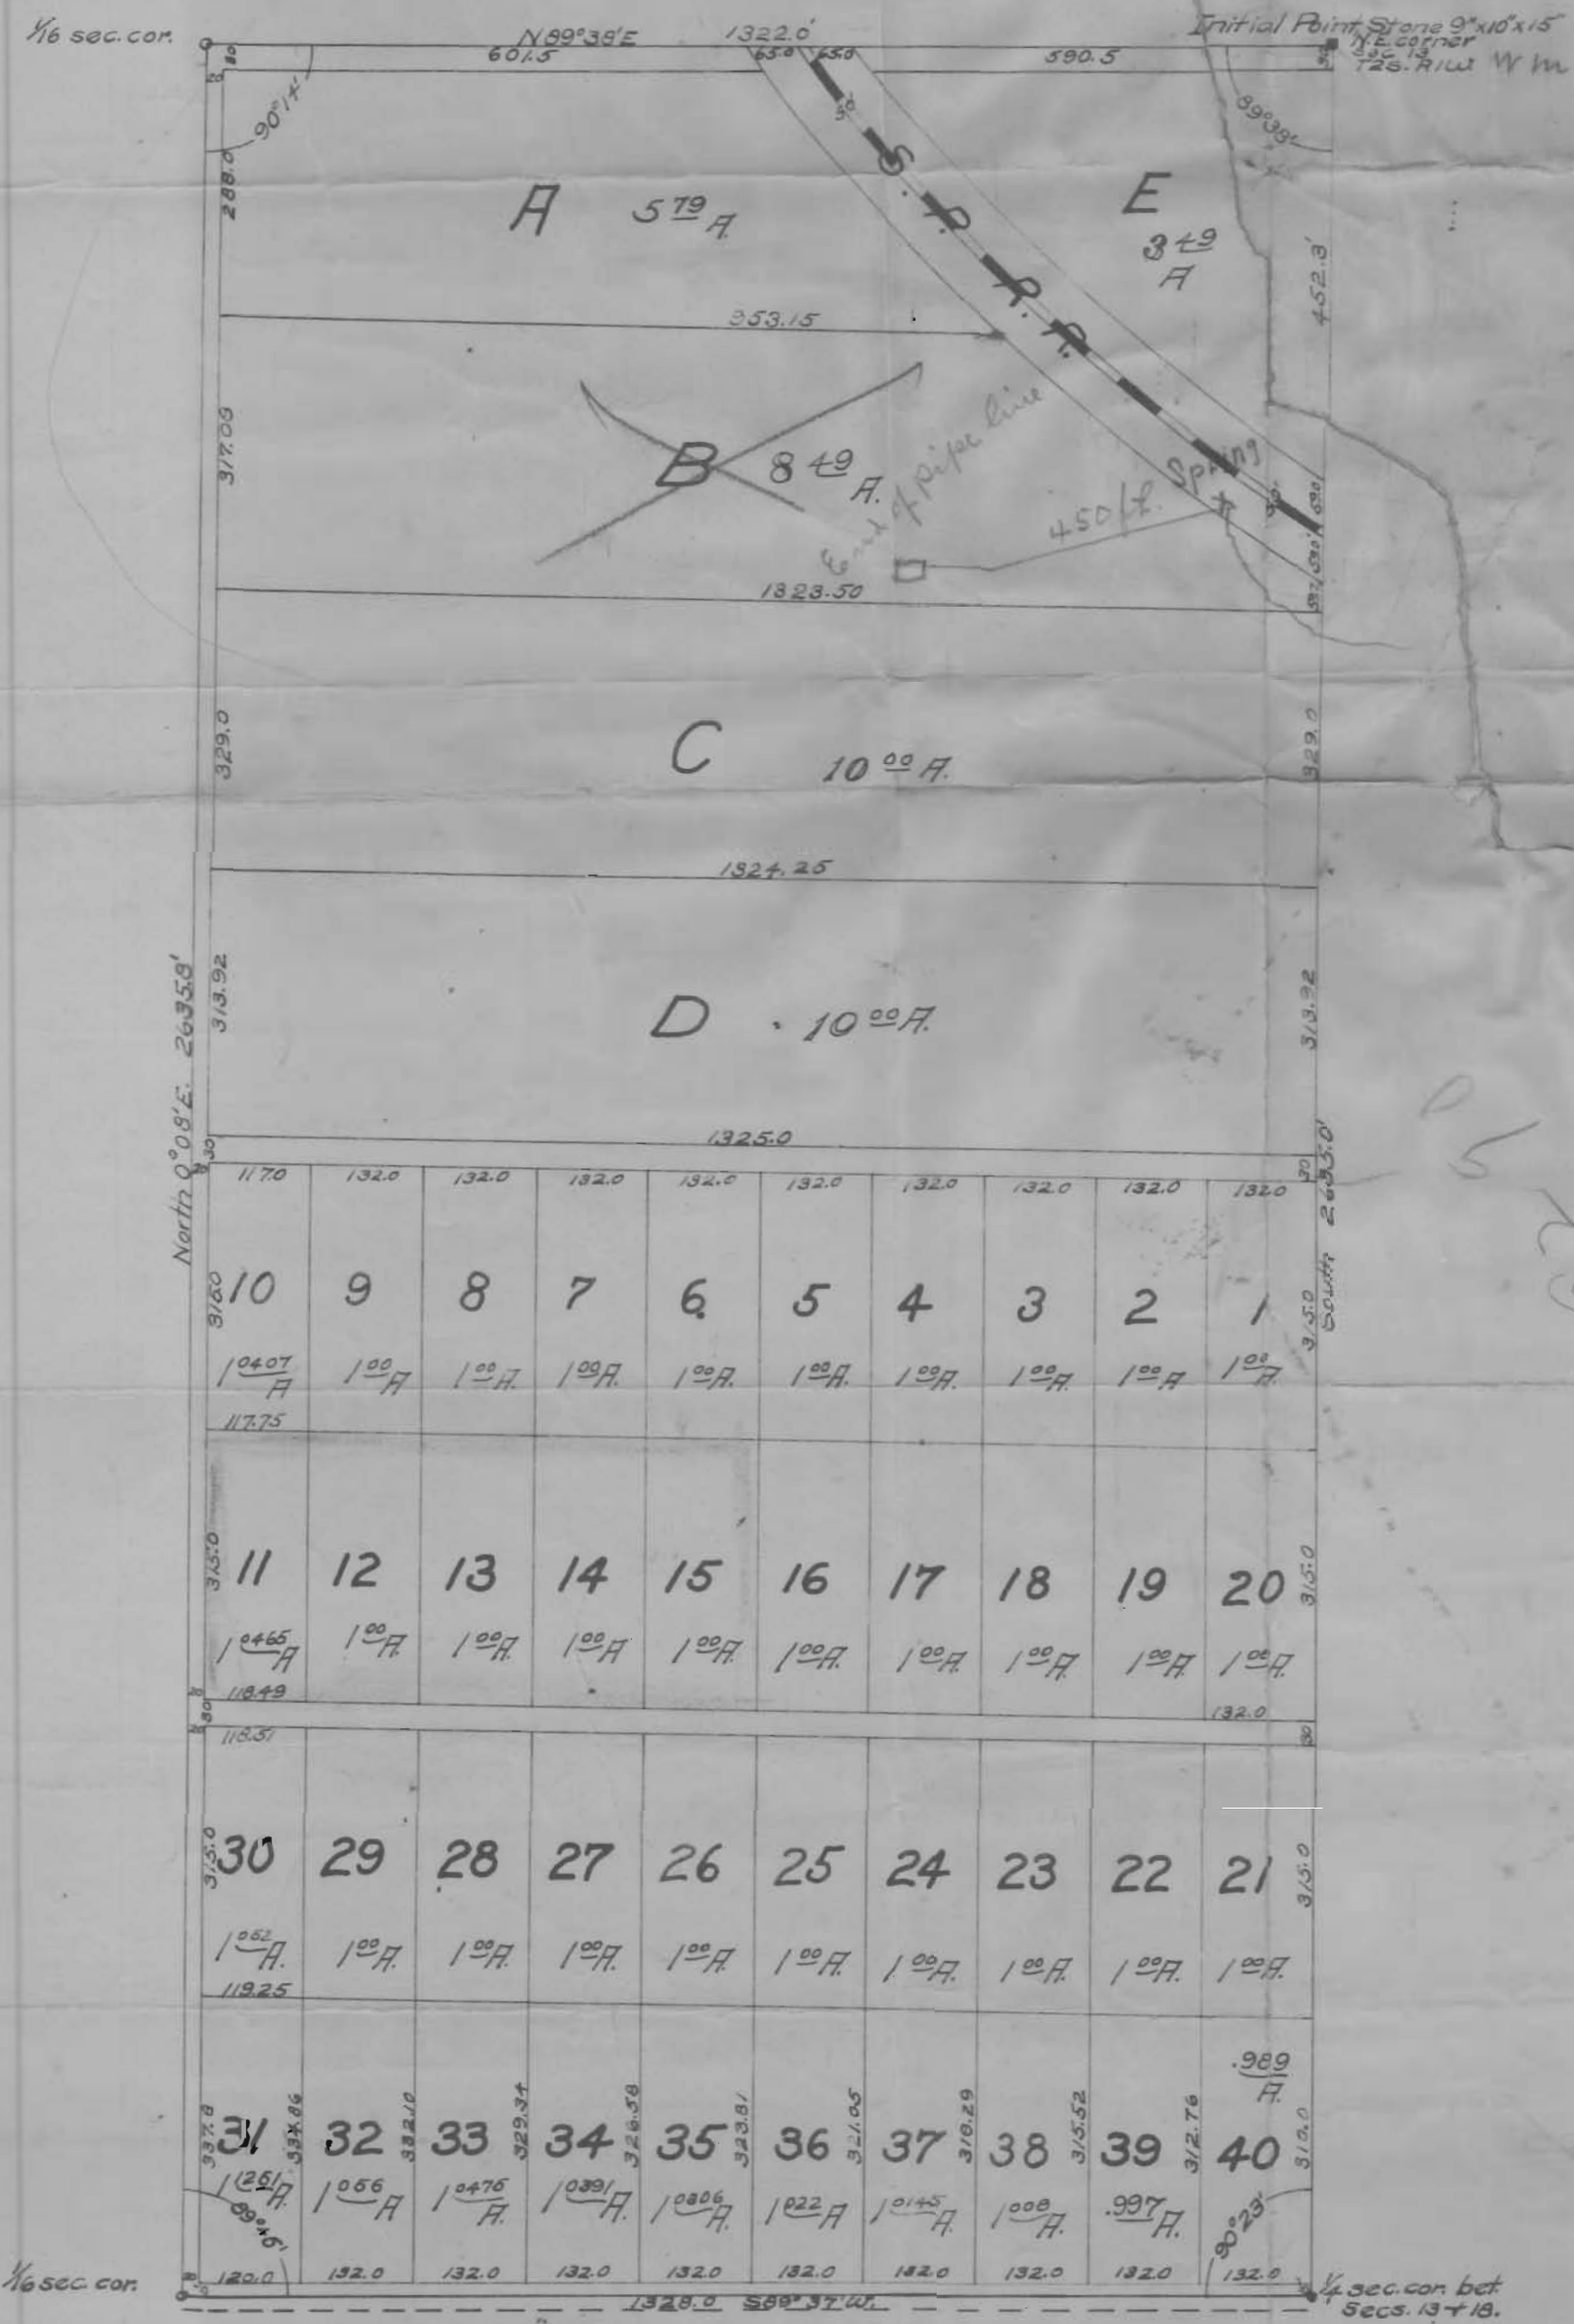

	1170	132.0	132.0	132.0	132.0	132.0	132.0	132.0	132.0	132.0
3160	10	9	8	7	6	5	4	3	2	1
	$\frac{10407}{1}$ A	$\frac{100}{1}$ A	$\frac{100}{1}$ A	$\frac{100}{1}$ A	$\frac{100}{1}$ A	$\frac{100}{1}$ A	$\frac{100}{1}$ A	$\frac{100}{1}$ A	$\frac{100}{1}$ A	$\frac{100}{1}$ A
3150	11	12	13	14	15	16	17	18	19	20
	$\frac{10455}{1}$ A	$\frac{100}{1}$ A	$\frac{100}{1}$ A	$\frac{100}{1}$ A	$\frac{100}{1}$ A	$\frac{100}{1}$ A	$\frac{100}{1}$ A	$\frac{100}{1}$ A	$\frac{100}{1}$ A	$\frac{100}{1}$ A
	64.81									132.0
3140	30	29	28	27	26	25	24	23	22	21
	$\frac{1081}{1}$ A	$\frac{100}{1}$ A	$\frac{100}{1}$ A	$\frac{100}{1}$ A	$\frac{100}{1}$ A	$\frac{100}{1}$ A	$\frac{100}{1}$ A	$\frac{100}{1}$ A	$\frac{100}{1}$ A	$\frac{100}{1}$ A
	52.71									
3130	31	32	33	34	35	36	37	38	39	40
	$\frac{1051}{1}$ A	$\frac{1056}{1}$ A	$\frac{10476}{1}$ A	$\frac{10391}{1}$ A	$\frac{10806}{1}$ A	$\frac{1022}{1}$ A	$\frac{10145}{1}$ A	$\frac{1008}{1}$ A	$\frac{997}{1}$ A	$\frac{989}{1}$ A
120.0	132.0	132.0	132.0	132.0	132.0	132.0	132.0	132.0	132.0	132.0

