


T.2N., R.33E., W.M.  
NE.1/4 NE.1/4

21-10751  
66871

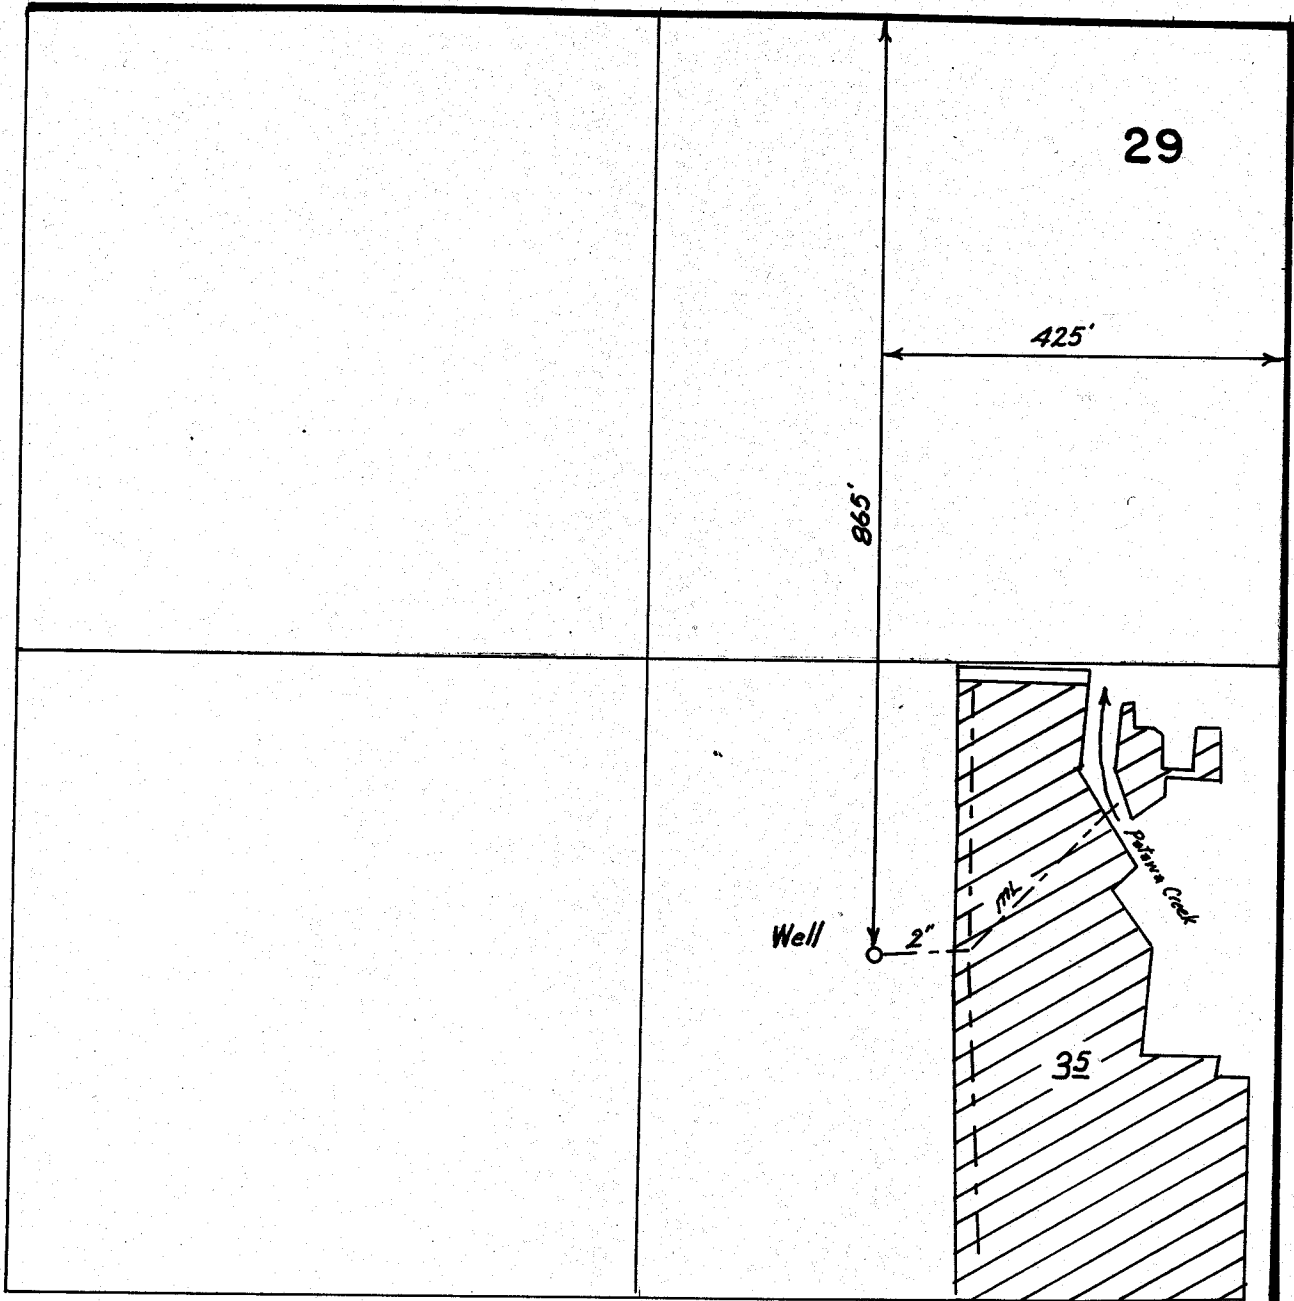

**FINAL PROOF SURVEY**  
UNDER

Application No. G11633 Permit No. G10751...  
IN NAME OF

.....MICHAEL LEE DAVIS.....

Surveyed ..11-29... 19.90., by .K.Kemp.....



Scale: 1" = 200'

PTS 3/91 KK