


T.3N., R.39E., W.M.

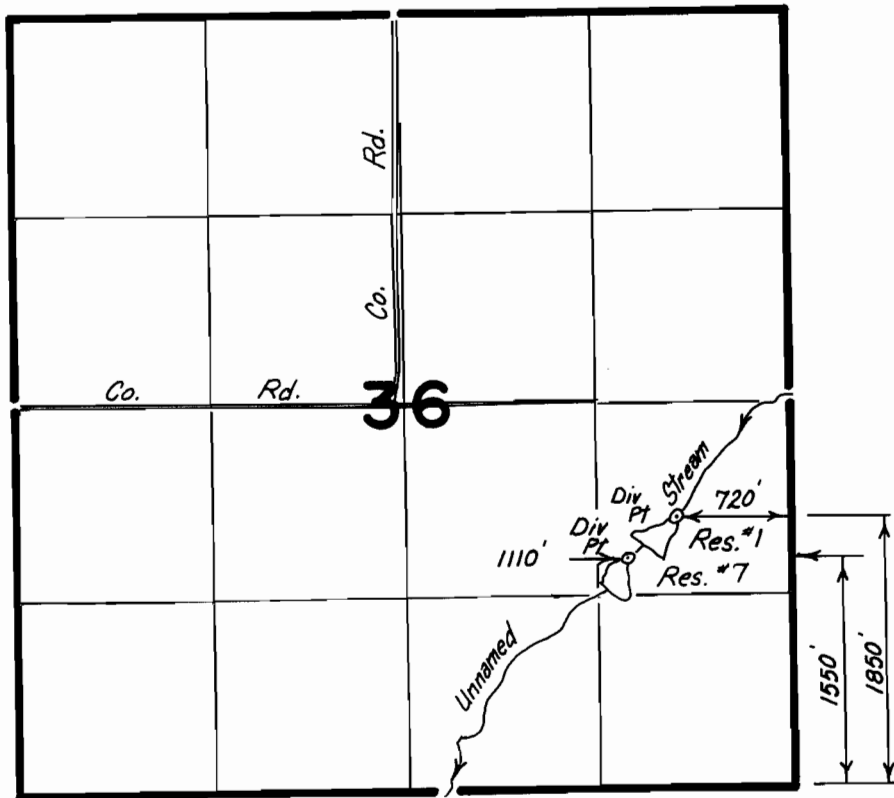

FINAL PROOF SURVEY
UNDER

Scale: 1" = 1320'

Application No. **R47416** Permit No. **R6716**.....
IN NAME OF

.....**LEE THOMAS INSKO**.....

Surveyed ...9-28... 1988., by ..Vern...Church.....