


T. 37 S., R. 4 W., W. M.

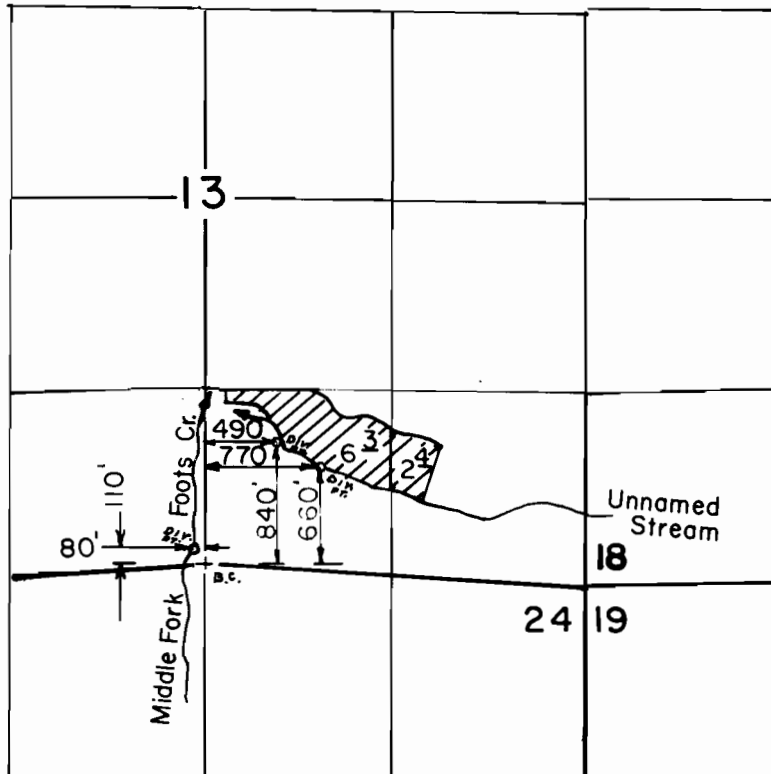

Scale: 1" = 1320'

FINAL PROOF SURVEY
UNDER

Application No. 51927 Permit No. 39067
IN NAME OF

.....NEWTON J. ELDER.....

Surveyed NOV. 7 1990, by B. S. JAMES.....