C-66898 P-49608
P-37727
C-66875

T.9S., R.27E., W.M.

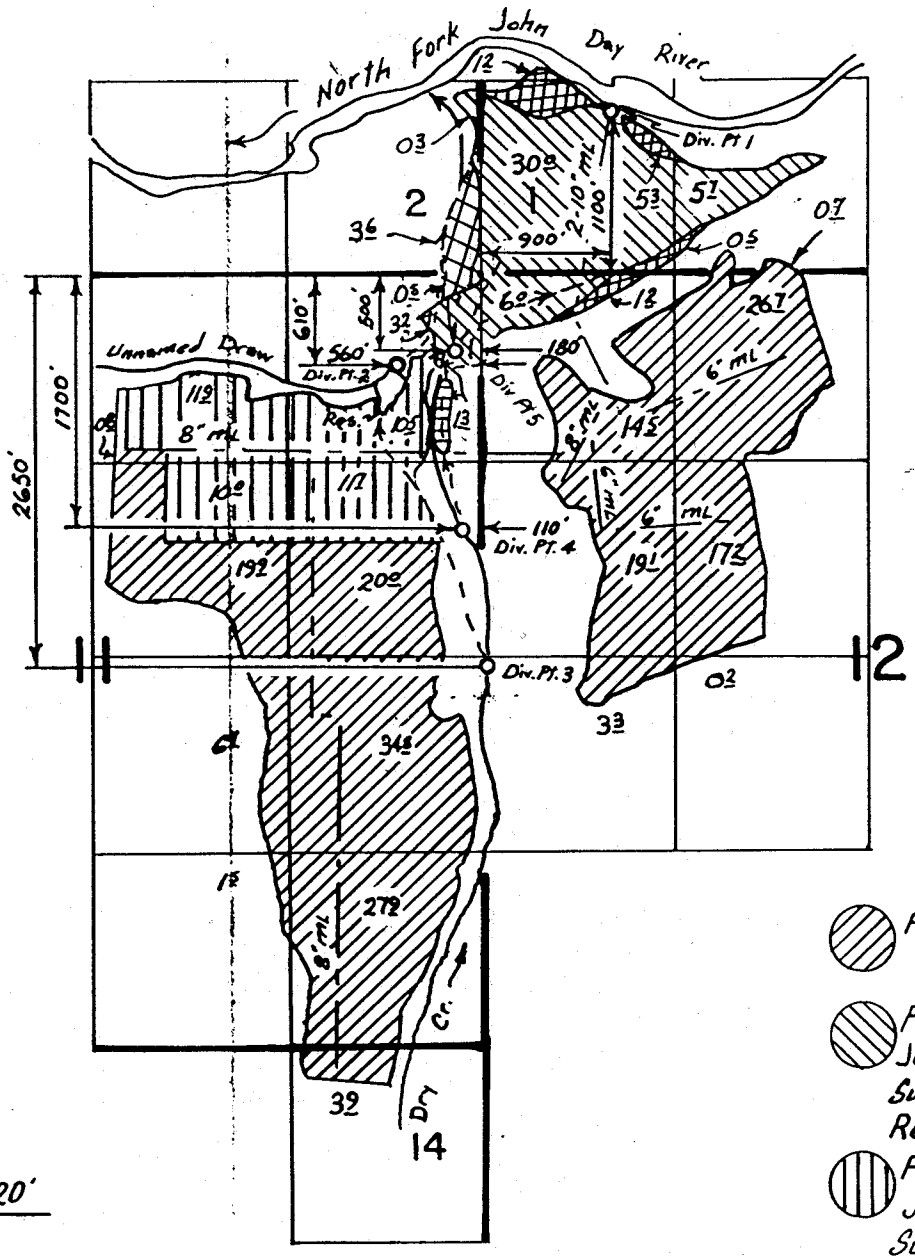

Scale: 1" = 1320'

Primary - North Fork John Day River, P# 37727

Primary - North Fork John Day River, C# 37663
Supplemental - Dry Creek, Reservoir, P# 49608

Primary - North Fork John Day River
Supplemental - Reservoir P# 49608

Primary - North Fork John Day River
Supplemental - Dry Creek, Reservoir P# 49608

Primary - Dry Creek P# 49608

Primary - Dry Creek
Supplemental - unnamed draw, North Fork John Day River, Reservoir P# 49608

FINAL PROOF SURVEY

UNDER

52616 37727
65245 49608

Application No. R65249 Permit No. R10604

IN NAME OF

PHILIP W. MURPHY

Surveyed 2-27 1991, by K. Kemp

41023-179-123R 3/91 KK