
P-39736
RR. 7/7/75

T. 41S., R. 4E., W. M.

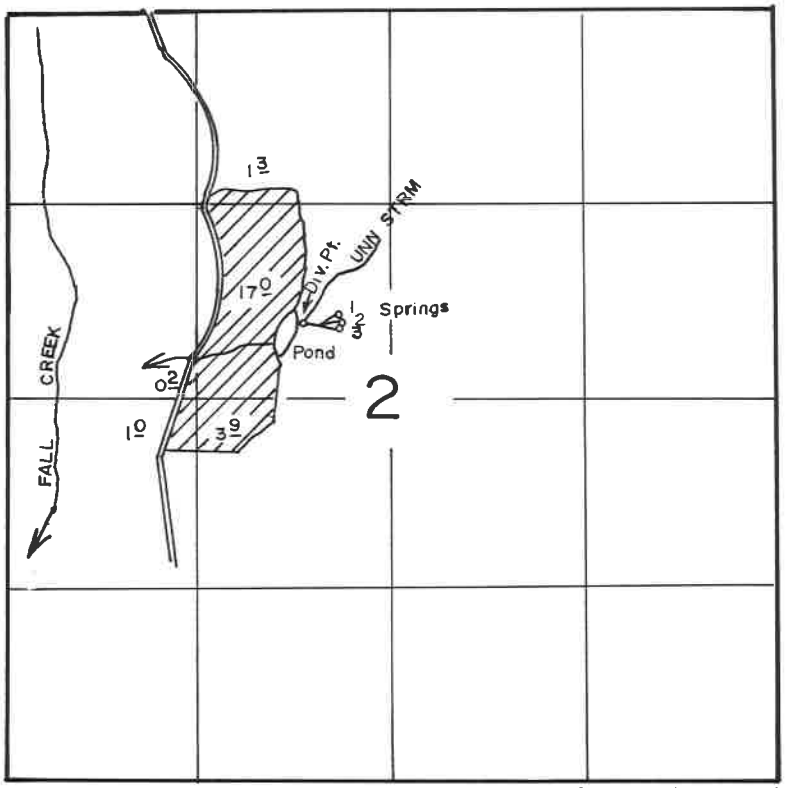

N

STRM DIV LOC 520'N & 2050', SPRINGS LOC, 1-590'N & 2250'E, 2-540'N & 2300'E, 3-490'N & 2270'E, ALL FROM W1/4 CORNER OF SECTION 2

SCALE: 1" = 1320'

FINAL PROOF SURVEY

UNDER

Application No. 53384 Permit No. 39736

IN NAME OF

LARRY A. LEONARD

Surveyed NOV. 29. 1989., by B.S. JAMES

41029-279-38 L

1-25-90 DM