


T.3&4S., R.4W., W.M.

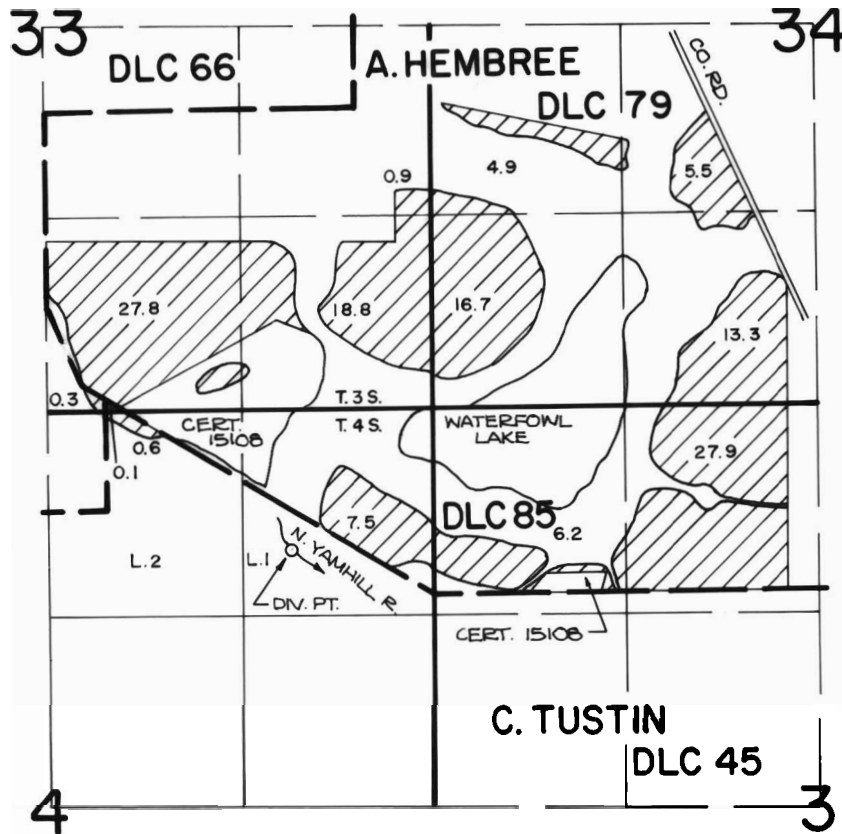

DIV. PT. LOCATION: 300 FT. N. AND 960 FT. W. FROM THE S'LY S.W. CORNER OF THE A. HEMBREE DLC 85.

FINAL PROOF SURVEY
UNDER

Application No. ~~56268~~ Permit No. ~~43178~~.....
IN NAME OF

HERBERT H. ANDERSON

Surveyed JUNE 20, 1984, by P. Patten.....



SCALE: 4" = 1 MILE