


T. 34 S., R. 5 W., W. M.

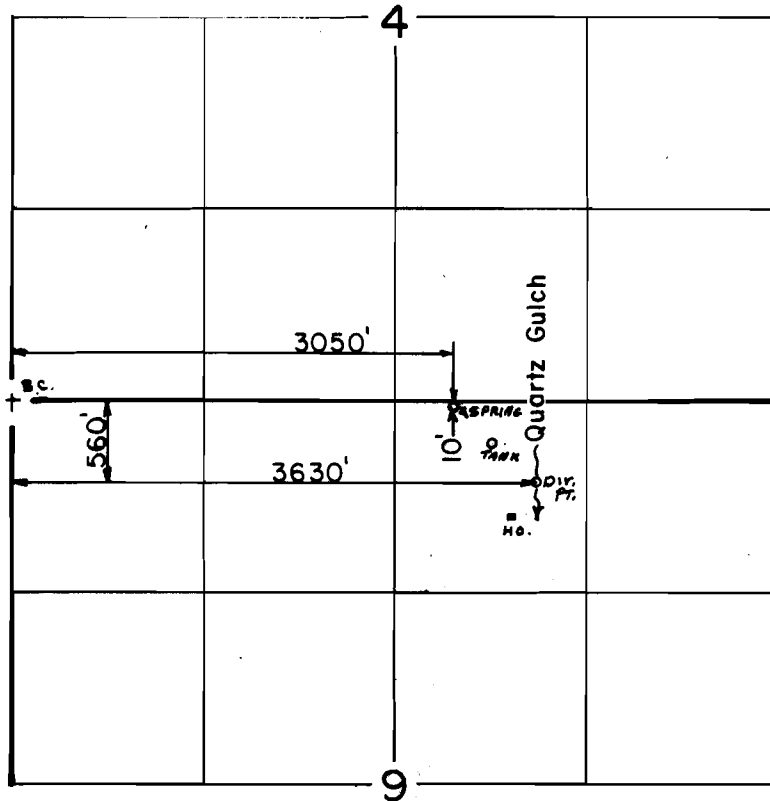

Scale: 1" = 1320'

**FINAL PROOF SURVEY**  
UNDER

Application No. 562.7.2 Permit No. 42139....  
IN NAME OF

GORDON..... &..... ANE..... MARI..... ERICKSON

Surveyed MAY!!.... 1989., by B..S...JAMES....