


43333
66882

T.39S., R.24E., W.M.

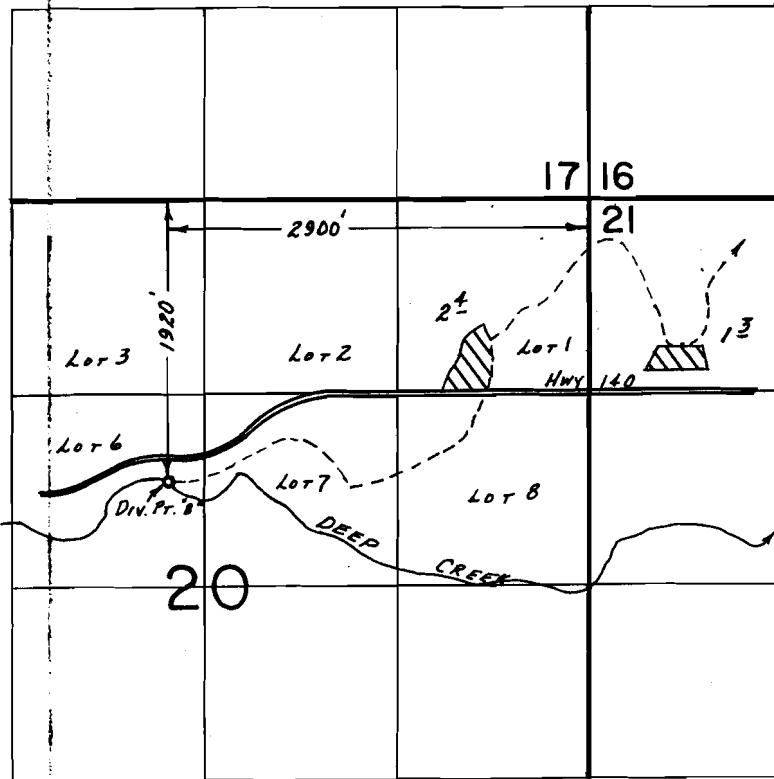

SCALE: 1" = 1320'

FINAL PROOF SURVEY
UNDER

Application No. 57563. Permit No. 43333
IN NAME OF Cert. # 66882

.....EARL E. ROGERS.....

Surveyed Nov. 28, 1990., by B.W. BISHOP....