


T.4N., R.42E., W.M.

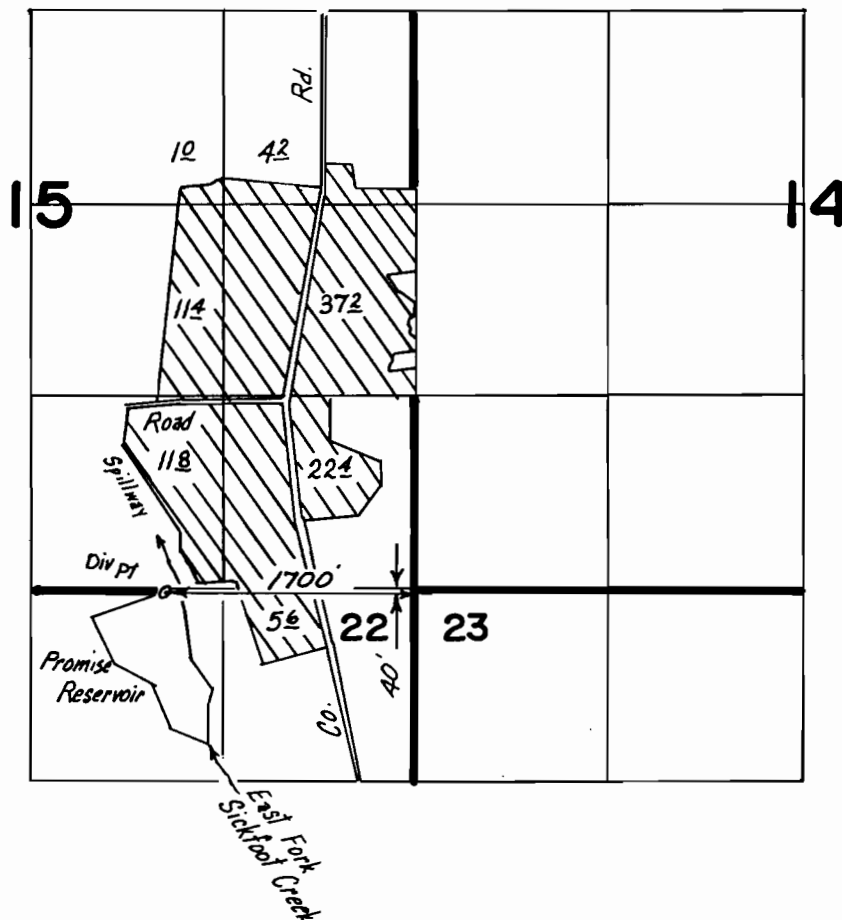

FINAL PROOF SURVEY
UNDER

R-59174 R-8175
Application No. 59175 Permit No. 45047
IN NAME OF

JAMES L HENDERSON

Surveyed 8-17-1988, by Vern Church

Scale: 1" = 1320'