



T. 15., R. 38E., W. M.

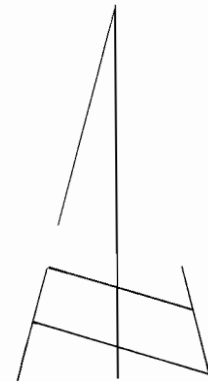

SCALE 1" = 1320'

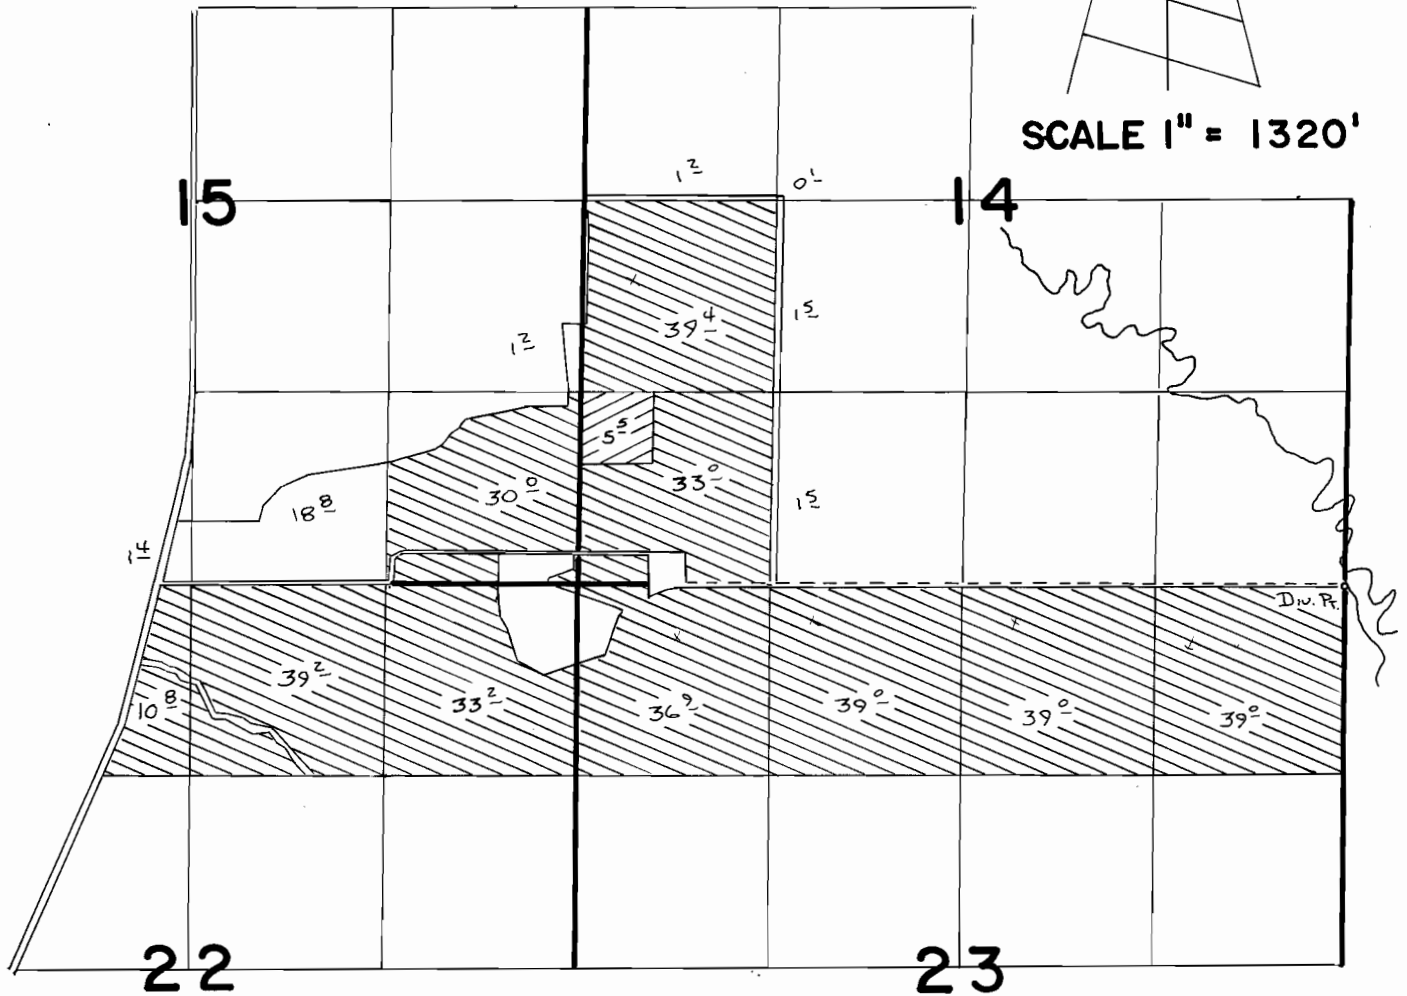

Div. Pt. Loc: 10'S. & 10'W. FROM NE COR. SEC 23



SUPPL



Prim.

FINAL PROOF SURVEY
UNDER

Application No. **59317**. Permit No. **45003**..
IN NAME OF

ALFRED A. ARNOLDUS & HEIRS.

Surveyed ..7..17..... 1984, by V. G. Chubb.....