


T. 34 S., R. 5 W., W. M.

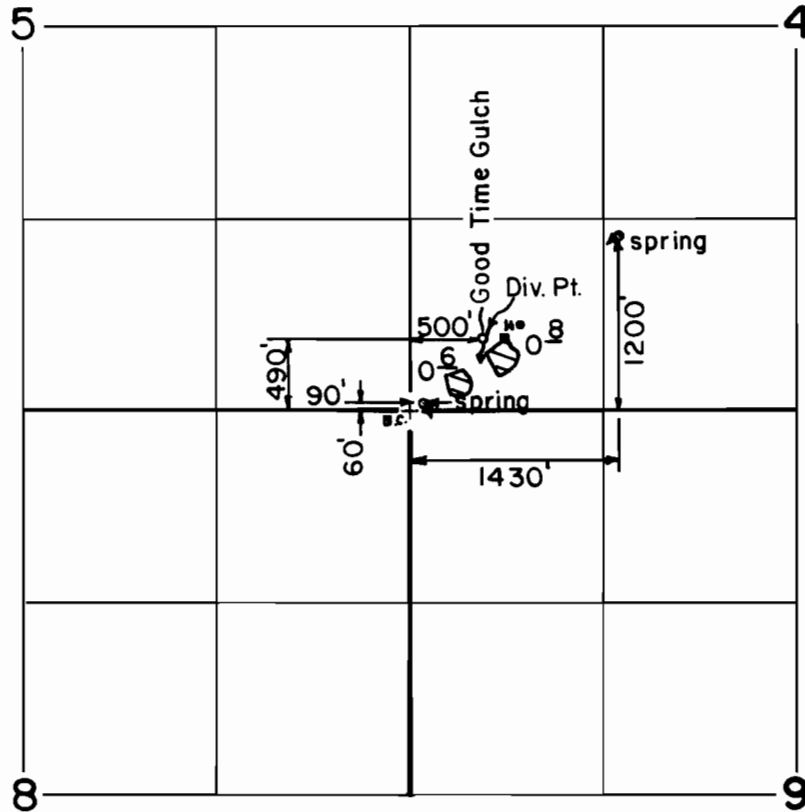

Scale: 1" = 1320'

FINAL PROOF SURVEY
UNDER

60607 46468
Application No. ~~68928~~ Permit No. ~~49829~~...
IN NAME OF

.....LYNETTE.....GREGORY.....

Surveyed AUG..7.. 19.90, by B..S..JAMES...