


T. 34 S., R. 5 W., W. M.

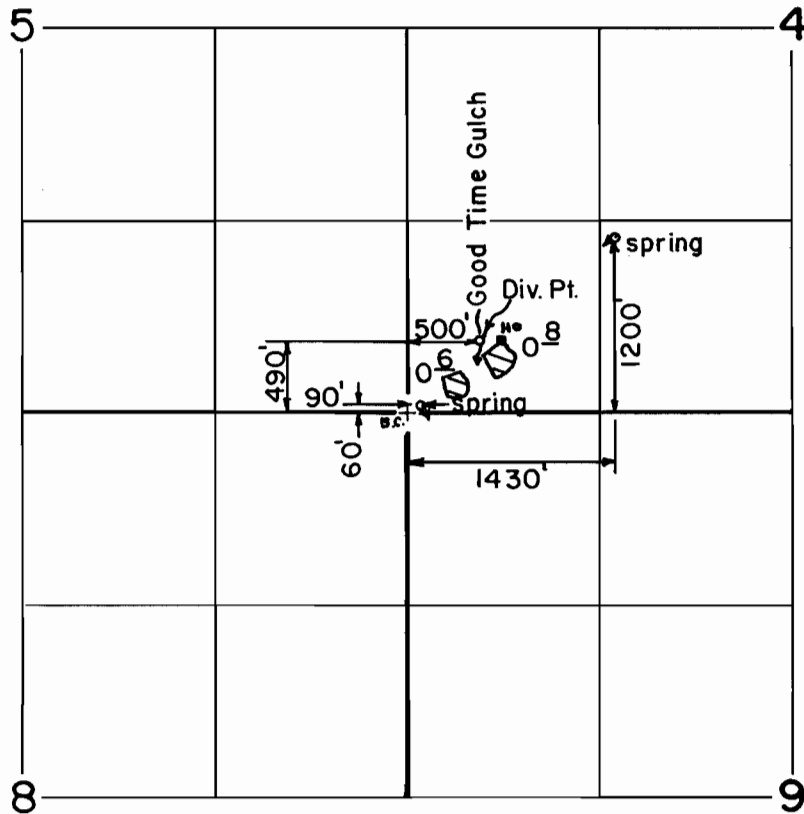

Scale: 1" = 1320'

FINAL PROOF SURVEY
UNDER

60607 46468
Application No. 68928 Permit No. 49829...
IN NAME OF

.....LYNETTE.....GREGORY.....

Surveyed AUG. 7... 19.90, by B. S. JAMES...