


T. 6N., R. 34E., W. M.

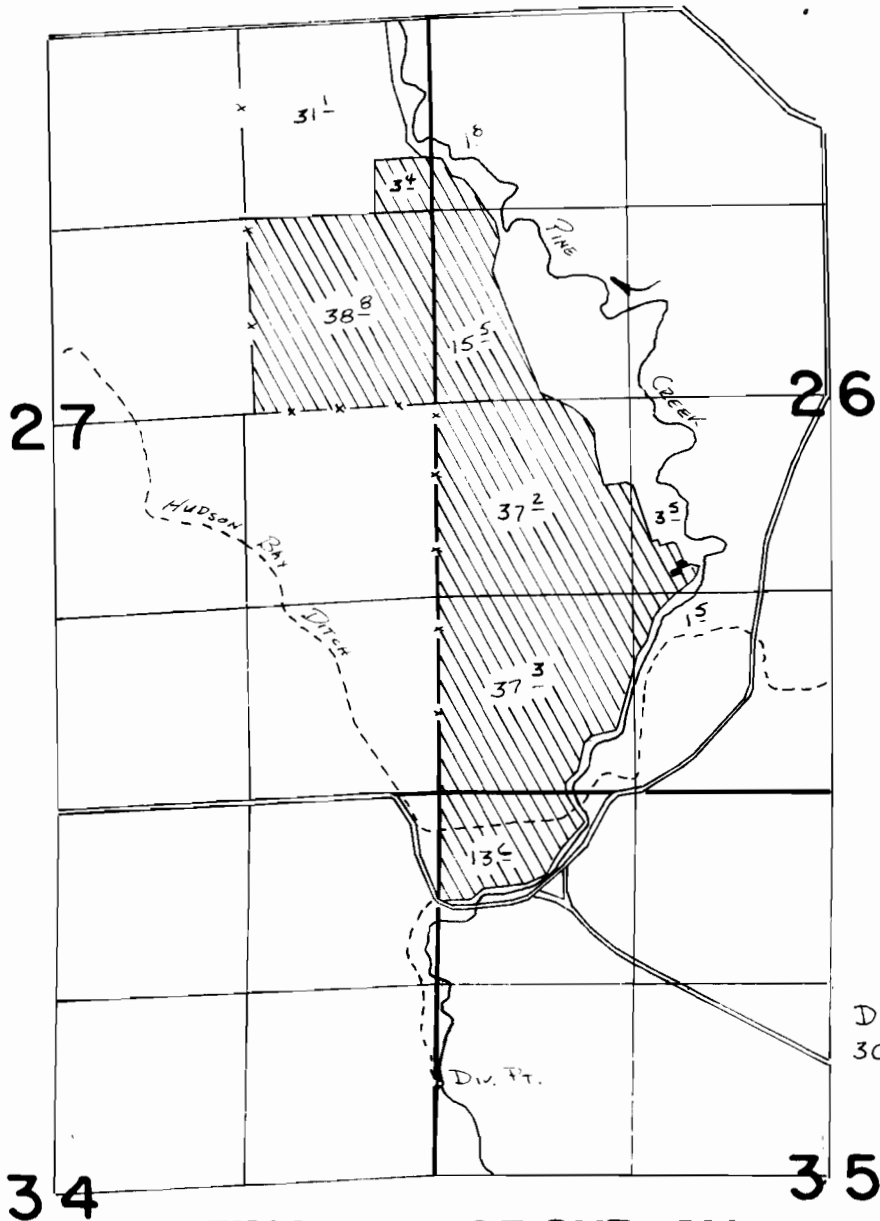

SCALE: 1" = 1320'

Div. Pt. LOCATED 2000'S ±
30' E. FROM NW COR. SEC 35

FINAL PROOF SURVEY
UNDER

Application No. **60981**.. Permit No. **45339**....
IN NAME OF

ROY & WAYNE SCOTT WALLACE

Surveyed **4-30**..... 19**85**., by **V.L.C.**.....