


T. 40 S., R. 14 W., W.M.

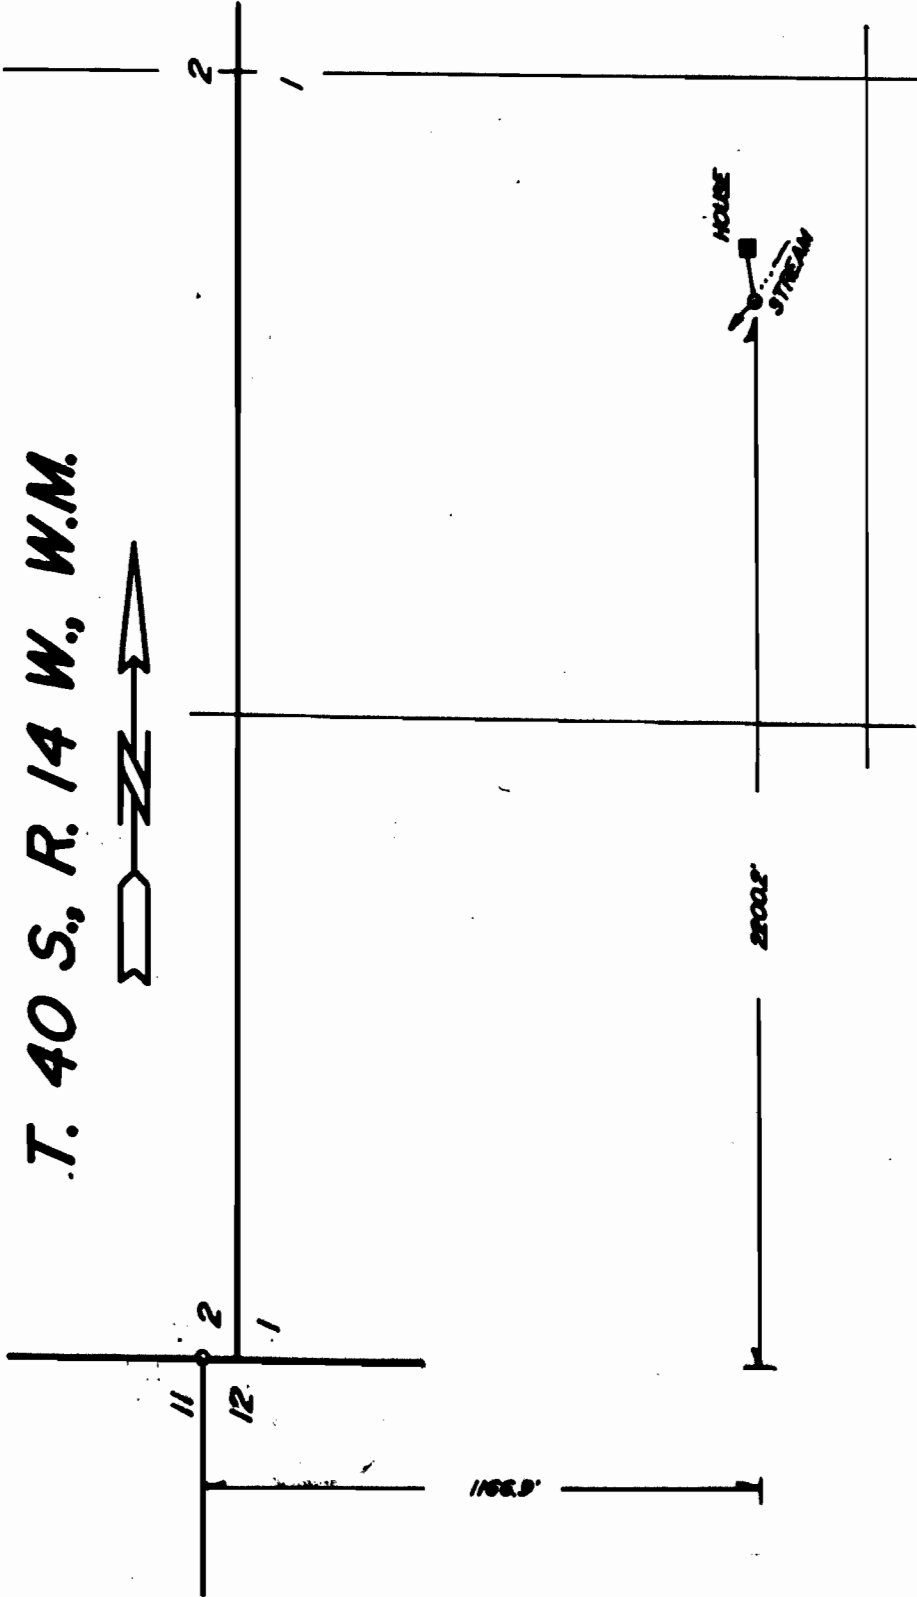

FINAL PROOF SURVEY

UNDER

Application # 70933 Permit # 51226

IN THE NAME OF

RON GALCHUTT

Surveyed June 19, 1991, by H.L. Newhouse

Scale 1" = 400'

The preparation of this map was for the purpose of identifying the location of the proposed water right and has no intent to provide dimensions or location of property lines.

